

15.185.13144-0000 GED

STATE OF KANSAS
STATE CORPORATION COMMISSION

19
WELL PLUGGING RECORD

Give All Information Completely
Make Required Affidavit
Mail or Deliver Report to:
Conservation Division
State Corporation Commission
212 North Market, Insurance Bldg.
Wichita, Kansas

Stafford County. Sec. 3 Twp. 21 Rge. 12 (E) W (W)

Location as "NE/CNW/SW" or footage from lines N/2 NE NW

Lease Owner Inger Oil Company

Lease Name Wolf Well No. 4

Office Address 401 Schweiter Bldg., Wichita, Kansas

Character of Well (completed as Oil, Gas or Dry Hole) Oil

Date well completed December 9 19 55

Application for plugging filed 19

Application for plugging approved 19


Plugging commenced February 6 19 61

Plugging completed February 9 19 61

Reason for abandonment of well or producing formation Depleted

If a producing well is abandoned, date of last production 19

Was permission obtained from the Conservation Division or its agents before plugging was commenced?

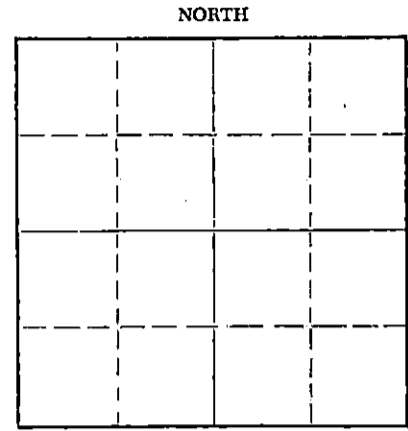

Locate well correctly on above Section Plat

Name of Conservation Agent who supervised plugging of this well Frank, Broadfoot

Producing formation _____ Depth to top _____ Bottom _____ Total Depth of Well 3399 Feet

Show depth and thickness of all water, oil and gas formations.

OIL, GAS OR WATER RECORDS

CASING RECORD

FORMATION	CONTENT	FROM	TO	SIZE	PUT IN	PULLED OUT
				8"	615	None
				5"	3396	2629

Describe in detail the manner in which the well was plugged, indicating where the mud fluid was placed and the method or methods used in introducing it into the hole. If cement or other plugs were used, state the character of same and depth placed, from _____ feet to _____ feet for each plug set.

Sanded hole from 3399 to 3380
Dumped 5 Sacks of cement
Bailed hole to 240'
Set 15' rock bridge and 20 sacks cement
Finished filling hole with mud to 30'
10 sacks of cement as cap

RECEIVED
STATE CORPORATION COMMISSION
AUG 2 1962
CONSERVATION DIVISION
Wichita, Kansas

Name of Plugging Contractor PIPE PULLERS, INC.
Address 486 Ellinwood, Kansas

STATE OF Barton COUNTY OF Kansas, ss.
Dean Wells, contractor (employee or owner) or (owner or operator) of the above-described

well, being first duly sworn on oath, says: That I have knowledge of the facts, statements, and matters herein contained and the log of the above-described well as filed and that the same are true and correct. So help me God.

(Signature) Dean Wells

Box 486, Ellinwood, Kansas
(Address)

SUBSCRIBED AND SWORN TO before me this 20 day of Feb, 19 61

My commission expires Feb 10, 1963 George A. Meyer Notary Public.



Well Log
 Wolf #4
 NW/4 of NE/4 3-21-12
 Stafford County, Kansas

0 - 188	Sand - soil
188 - 275	Sand
275 - 455	Red bed
455 - 605	Sand and red bed
605 - 615	Anhydrite
615 - 1074	Anhydrite and shale
1074 - 1330	Shale
1330 - 1405	Sand - shale
1405 - 1455	Shale
1455 - 1595	Lime and shale
1595 - 1830	Lime, sand and shale
1830 - 1930	Lime
1930 - 1940	Shale and lime
1940 - 2390	Lime and shale
2390 - 2615	Shale and lime
2615 - 2840	Lime and shale
2840 - 3160	Lime
3160 - 3161	Brown lime
3161 - 3169	Shale
3169 - 3215	Lime, Kansas City
3215 - 3375	Lime
3375 - 3395	Lime and shale
3395 - 3399 $\frac{1}{2}$	Arbuckle
3399 $\frac{1}{2}$	T. D.

RECEIVED
 STATE CORPORATION COMMISSION

JAN 30 1961


CONSERVATION DIVISION
 Wichita, Kansas

STATE OF KANSAS
 COUNTY OF BARTON ss

Dick B. Evans, accountant for A. L. Jackson Drilling Company, being first duly sworn on oath says: That I have knowledge of the facts, statements, and matters herein contained and the log of the above described well as filed and that the same are true and correct.


 Dick B. Evans

Subscribed and sworn before me this 30th day of November, 1955.


 Virgil E. Belford, Jr.
 Notary Public Barton County

My Commission expires April 27, 1957.