


STATE OF KANSAS  
STATE CORPORATION COMMISSION

REED/OGY  
15.185.13/46.0000  
**WELL PLUGGING RECORD**

Give All Information Completely  
Make Required Affidavit  
Mail or Deliver Report to:  
Conservation Division  
State Corporation Commission  
212 North Market, Insurance Bldg.  
Wichita, Kansas

Stafford County. Sec. 3 Twp. 21 Rge. 12 (E) W (W)

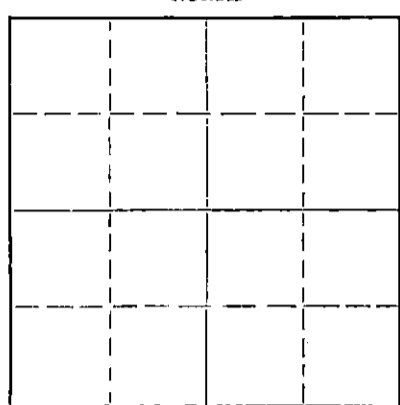

Locate well correctly on above Section Plat

Location as "NE/CNW/SW" or footage from lines NW NE NW  
Lease Owner Inger Oil Company  
Lease Name Wolf Well No. 6  
Office Address 401 Schweiter Bldg., Wichita, Kansas  
Character of Well (completed as Oil, Gas or Dry Hole) Oil  
Date well completed January 20 19 56  
Application for plugging filed 19  
Application for plugging approved 19  
Plugging commenced February 2 19 61  
Plugging completed February 5 19 61  
Reason for abandonment of well or producing formation Depleted

If a producing well is abandoned, date of last production 19  
Was permission obtained from the Conservation Division or its agents before plugging was commenced?

Name of Conservation Agent who supervised plugging of this well Frank Broadfoot  
Producing formation \_\_\_\_\_ Depth to top \_\_\_\_\_ Bottom \_\_\_\_\_ Total Depth of Well 3405 Feet  
Show depth and thickness of all water, oil and gas formations.

OIL, GAS OR WATER RECORDS				CASING RECORD		
FORMATION	CONTENT	FROM	TO	SIZE	PUT IN	PULLED OUT
				8"	610'	None
				5"	3403	2625

Describe in detail the manner in which the well was plugged, indicating where the mud fluid was placed and the method or methods used in introducing it into the hole. If cement or other plugs were used, state the character of same and depth placed, from \_\_\_\_\_ feet to \_\_\_\_\_ feet for each plug set.

Sanded hole from 3405 to 3385  
Dumped 5 sacks of cement  
Bailed hole to 240'  
Set 15' rock bridge  
Finished filling hole with mud to 30'  
10 sacks of cement as cap.

**RECEIVED**  
STATE CORPORATION COMMISSION  
AUG 2 1962 8-2-62  
CONSERVATION DIVISION  
Wichita, Kansas

Name of Plugging Contractor PIPE PULLERS, INC. (If additional description is necessary, use BACK of this sheet)  
Address 486 Ellinwood, Kansas

STATE OF Kansas COUNTY OF Barton, ss.  
Dean Wells, contractor (employee or owner) or (owner or operator) of the above-described well, being first duly sworn on oath, says: That I have knowledge of the facts, statements, and matters herein contained and the log of the above-described well as filed and that the same are true and correct. So help me God.  
(Signature) Dean Wells  
Box 486, Ellinwood, Kansas (Address)

SUBSCRIBED AND SWORN TO before me this 20 Feb day of February, 19 61  
Feb 10, 1963 My commission expires  
Serge A Meyer Notary Public.

Well Log  
 Wolf # 6  
 NW NE NW 3-21-12  
 Stafford County, Kansas

0	-	30	Soil - sand
30	-	200	Sand
200	-	227	Blue shale
227	-	625	Shale & red bed
625	-	645	Anhydrite
645	-	875	Shale & shells
875	-	1425	Shale, shells & salt
1425	-	1450	Sand, shale & shells
1450	-	1655	Lime & shale
1655	-	1695	Fort Riley
1695	-	1885	Lime & shale
1885	-	2035	Lime & shale (sandy)
2035	-	2200	Lime & shale
2200	-	2340	Lime & shale (sandy)
2340	-	2760	Lime & shale
2760	-	3029	Lime
3029	-	3100	Shale & lime
3100	-	3157	Douglas
3157	-	3173	Brown lime
3173	-	3185	Kansas City lime
3185	-	3405	Lime
3405	-		TD

Date Commenced Dec 9, 1955  
 Date Completed Dec 19, 1955

STATE OF KANSAS  
 COUNTY OF BARTON SS

Dick B. Evans accountant for A. L. Jackson Drilling Company, being first duly sworn on oath says: That I have knowledge of the facts, statements, and matters herein contained and the log of the above described well as filed and that the same are true and correct.

Dick B. Evans  
 Dick B. Evans

Subscribed and sworn before me this 21st. day of December, 1955.

Virgil E. Belford, Jr.  
 Virgil E. Belford, Jr.  
 Notary Public Barton County

My Commission expires April 27, 1957

RECEIVED  
 STATE OF KANSAS CONSERVATION

JAN 30 1956

CONSERVATION DIVISION  
 Wichita, Kansas