


STATE OF KANSAS  
STATE CORPORATION COMMISSION

WELL PLUGGING RECORD

Give All Information Completely  
Make Required Affidavit  
Mail or Deliver Report to:  
Conservation Division  
State Corporation Commission  
800 Bittling Building  
Wichita, Kansas

Stafford County, Sec. 3 Twp. 21S Rge. 12 (E) W (W)

Location as "NE/CNW%SW%" or footage from lines NW SE NE  
Lease Owner Martin Wunderlich  
Lease Name John F. Wolf Well No. 5  
Office Address 206 Patterson Bldg. Omaha 2, Nebraska  
Character of Well (completed as Oil, Gas or Dry Hole) Oil  
Date well completed December 8, 1955  
Application for plugging filed August 23 1956  
Application for plugging approved August 23 1956  
Plugging commenced September 17 1956  
Plugging completed September 17 1956  
Reason for abandonment of well or producing formation Non-Production

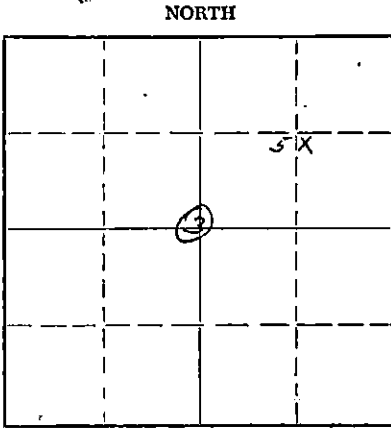

Locate well correctly on above  
Section Plat

If a producing well is abandoned, date of last production July 1956  
Was permission obtained from the Conservation Division or its agents before plugging was commenced? Yes

Name of Conservation Agent who supervised plugging of this well  
Producing formation Arbuckle Depth to top 3460' Bottom 3468' Total Depth of Well 3465' Feet  
Show depth and thickness of all water, oil and gas formations.

OIL, GAS OR WATER RECORDS

CASING RECORD

FORMATION	CONTENT	FROM	TO	SIZE	PUT IN	PULLED OUT
				8-5/8"	240'	-0-
				5 1/2"	3458'	2961'

Describe in detail the manner in which the well was plugged, indicating where the mud fluid was placed and the method or methods used in introducing it into the hole. If cement or other plugs were used, state the character of same and depth placed, from \_\_\_\_\_ feet to \_\_\_\_\_ feet for each plug set.  
Chunk mud etc. to 225' rock bridge 225' to 215' dumped 10 sacks cement, 10 sacks cement filling with chunk mud to 45' rock bridge 45' to 35', mixing 10 sacks of cement and capping top of surface

(If additional description is necessary, use BACK of this sheet)

Name of Plugging Contractor Smith & Smith Casing Pulling Co.  
Address Duncan, Oklahoma

STATE OF Nebraska, COUNTY OF Douglas, ss.  
William R. Hosier (employee of owner) or (owner or operator) of the above-described well, being first duly sworn on oath, says: That I have knowledge of the facts, statements, and matters herein contained and the log of the above-described well as filed and that the same are true and correct. So help me God.

(Signature) William R. Hosier  
206 Patterson Bldg., Omaha 2, Nebraska  
(Address)

SUBSCRIBED AND SWORN TO before me this 21st day of November, 1956

My commission expires November 24, 1961

Notary Public.  
STATE CORPORATION COMMISSION

PLUGGING  
FILE SEC 3 T. 21 R. 12W  
BOOK PAGE 92 LINE 24

NOV 25 1956  
CONSERVATION DIVISION  
Wichita, Kansas

11-23-56

*File*

Well Log  
Wolf #5 *Daly*  
NW Corner SE/4 N/2 3-21-12  
Stafford County, Kansas

*Wunderlich + Inger  
401 Schweitzer Bldg.*

0 - 230	Sand
230 - 240	Red bed
240 - 260	Shale
260 - 600	Red bed
600 - 640	Anhydrite
640 - 670	Hard sand rock
670 - 1120	Red bed, shale and sholls
1120 - 1380	Shale, shells - Lime streaks
1380 - 1400	Sand and shale
1400 - 1470	Shale and lime
1470 - 1655	Lime and shale
1655 - 1855	Sand and lime
1855 - 1935	Sandy lime
1935 - 2145	Shale and lime
2145 - 2325	Lime and shale
2325 - 2420	Sandy lime - shale
2420 - 2470	Shale and lime
2470 - 2535	Shale and shells
2535 - 2560	Lime
2560 - 2740	Lime and shale
2740 - 2775	Shale and lime
2775 - 2975	Lime
2975 - 3030	Lime, chert (sharp)
3030 - 3085	Lime
3085 - 3165	Lime and shale
3165 - 3182	Shale
3182 - 3190	Brown lime
3190 - 3197	Shale
3197 - 3240	Lime K.C.
3240 - 3385	Lime
3385 - 3445	Lime and shale
3445 - 3462	Shale and lime
3462	T. D.

STATE OF KANSAS  
COUNTY OF BARTON      ss

Dick B. Evans, accountant for A. L. Jackson Drilling Company, being first duly sworn on oath says: That I have knowledge of the facts, statements, and matters herein contained and the log of the above described well as filed and that the same are true and correct.


RECEIVED  
NOTARY COMMISSION

NOV 20 1955

CONSERVATION DIVISION  
Wichita, Kansas

*Dick B. Evans*  
Dick B. Evans

Subscribed and sworn before me this 13th day of December, 1955.

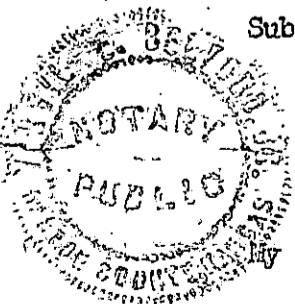

*Virgil E. Belford, Jr.*  
Virgil E. Belford, Jr.  
Notary Public Barton County

My commission expires April 27, 1957.

PLUGGING  
FILE SEC. 3 T. 21. R. 12W  
BOOK PAGE 92 LINE 24