


WELL PLUGGING RECORD

Give All Information Completely
Make Required Affidavit
Mail or Deliver Report to:
Conservation Division
State Corporation Commission
211 No. Broadway
Wichita, Kansas

Stafford County. Sec. 3 Twp. 21S Rge. 12 (E) W (W)
Location as "NE/CNW%SW%" or footage from lines SE SE NE
Lease Owner Martin Wunderlich
Lease Name John F. Wolf Well No. 3
Office Address 206 Patterson Bldg. Omaha 2, Nebraska
Character of Well (completed as Oil, Gas or Dry Hole) Oil
Date well completed 19
Application for plugging filed August 23 19 56
Application for plugging approved August 23 19 56
Plugging commenced September 15 19 56
Plugging completed September 15 19 56
Reason for abandonment of well or producing formation Non Production of Oil

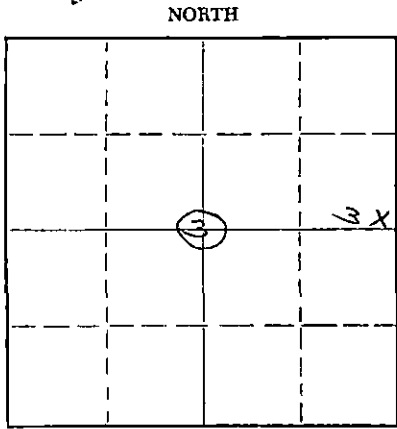

Locate well correctly on above
Section Plat

If a producing well is abandoned, date of last production July 19 56
Was permission obtained from the Conservation Division or its agents before plugging was commenced? Yes

Name of Conservation Agent who supervised plugging of this well Mr. R. M. Brundage
Producing formation Arbuckle Depth to top Bottom Total Depth of Well Feet
Show depth and thickness of all water, oil and gas formations.

OIL, GAS OR WATER RECORDS

CASING RECORD

FORMATION	CONTENT	FROM	TO	SIZE	PUT IN	PULLED OUT
				8-5/8"	250'	-0-
				5 1/2"	3500'	2861'

Describe in detail the manner in which the well was plugged, indicating where the mud fluid was placed and the method or methods used in introducing it into the hole. If cement or other plugs were used, state the character of same and depth placed, from feet to feet for each plug set.

Chunk mud etc bottom of hole to 220' Rock Bridge at 220'
Dumped 10 sacks of cement on top. 10 sacks cement and pouring in and filling surface to 40', chunk mud and rock plug to 35' and capping top with 10 sacks cement.

(If additional description is necessary, use BACK of this sheet)
Name of Plugging Contractor Smith and Smith Casing Pulling Co.
Address Duncan, Oklahoma

STATE OF Nebraska, COUNTY OF Douglas, ss.
William R. Hosier (employee of owner) or (owner or operator) of the above-described well, being first duly sworn on oath, says: That I have knowledge of the facts, statements, and matters herein contained and the log of the above-described well as filed and that the same are true and correct. So help me God.

(Signature) William R. Hosier
206 Patterson Bldg., Omaha 2, Nebraska
(Address)

SUBSCRIBED AND SWORN TO before me this 21st day of November, 19 56

My commission expires November 24, 1961

Lois Di Lorenzo Notary Public.

PLUGGING
FILE SEC 3 T. 21 R. 12W
BOOK PAGE 92 LINE 23

RECEIVED
STATE CORPORATION COMMISSION
NOV 25 1956 11-23-56
CONSERVATION DIVISION
Wichita, Kansas

KEWANEE OIL COMPANY

#3 Wolf SE SE NE 3-21-12W
Stafford County, Kansas

0	00	Sand
60	150	Sand
180	281	Shale & Red Bed
284	610	Red rock
610	615	Anhydrite
615	635	Anhydrite
635	940	Red rock
940	1190	Shale & shells
1190	1200	Shale & shells
1200	1295	Salt
1295	1425	Shale & shells
1425	1540	Shale & shells
1540	1690	Shale & broken lime
1690	1850	Shale & shale
1850	1940	Lime
1940	2020	Lime & shale
2020	2120	Lime & shale
2120	2280	Shale & shells
2280	2460	Shale & shells
2460	2590	Shale & shells
2590	2685	Shale & shells
2685	2795	Lime & shale
2795	2880	Lime & shale
2880	2930	Lime
2930	3005	Lime
3005	3057	Lime & shale
3057	3103	Lime
3103	3120	Shale
3120	3185	Sandy shale
3185	3225	Lime
3225	3285	Lime
3285	3330	Lime
3330	3390	Lime & shale
3390	3405	Lime & shale
3405	3440	Simpson shale
3440	3443	Simpson shale
3443	3448	Lime or buckle

COMMENCED: 4-28-51
COMPLETED: 5-9-51

CASING RECORD

Set 8-5/8" surface casing
at 270' with 300 sacks
cement.

RECEIVED
STATE OF KANSAS
COMMISSION
MAY 10 1951
CONSERVATION DIVISION
Wichita, Kansas

STATE OF KANSAS)
) SS
COUNTY OF SEDGWICK

I hereby affirm that the above and foregoing is a true and correct copy of the log of the #3 Wolf located SE SE NE 3-21-12, Stafford county, Kansas.

ANSCHUTZ DRILLING COMPANY, INC.

BY: *H. R. Jensen*

Subscribed and sworn to before me this 16th day of May, 1951.

Ernest Swenson

Notary Public

My commission expires October 24, 1953.

PLUGGING
SEC 3, T. 21 R. 12W
N. 3E. 92. LINE 23