


WELL PLUGGING RECORD

Give All Information Completely  
Make Required Affidavit  
Mail or Deliver Report to:  
Conservation Division  
State Corporation Commission  
800 Bitting Building  
Wichita, Kansas

NORTH

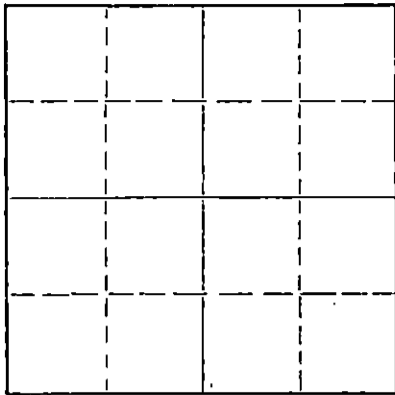

Locate well correctly on above  
Section Plat

Stafford County, Sec. 8 Twp. 21S Rge. 12W(E) (W)  
Location as "NE/CNWxSWx" or footage from lines SW SW SE  
Lease Owner Alpine Oil & Royalty Co., Inc & L. K. Parrish  
Lease Name Salem Well No. 1  
Office Address 1100 Bitting Building, Wichita, Kansas  
Character of Well (completed as Oil, Gas or Dry Hole) Dry hole  
Date well completed Feb. 1 1955  
Application for plugging filed Feb. 1 1955  
Application for plugging approved Feb. 1 1955  
Plugging commenced Feb. 15 1955  
Plugging completed Feb. 21 1955  
Reason for abandonment of well or producing formation non productive

If a producing well is abandoned, date of last production 19  
Was permission obtained from the Conservation Division or its agents before plugging was commenced? Yes

Name of Conservation Agent who supervised plugging of this well M. A. Rives  
Producing formation \_\_\_\_\_ Depth to top \_\_\_\_\_ Bottom \_\_\_\_\_ Total Depth of Well 3534 Feet  
Show depth and thickness of all water, oil and gas formations.

OIL, GAS OR WATER RECORDS

CASING RECORD

FORMATION	CONTENT	FROM	TO	SIZE	PUT IN	PULLED OUT
				8 5/8"	286'	cemented
				5 1/2"	3486'	2834'

Describe in detail the manner in which the well was plugged, indicating where the mud fluid was placed and the method or methods used in introducing it into the hole. If cement or other plugs were used, state the character of same and depth placed, from \_\_\_\_\_ feet to \_\_\_\_\_ feet for each plug set.

3535 to 3475 feet Sand bridge  
3475 to 3445 feet 5 sacks cement  
3445 to 285 feet Mudded  
285 to 270 feet Rock bridge  
270 to 210 feet 20 sacks cement  
210 to 35 feet Mud  
35 feet to cellar 10 sacks cement

RECEIVED  
STATE CORPORATION COMMISSION  
MAR 5 1955  
CONSERVATION DIVISION  
WICHITA, KANSAS

(If additional description is necessary, use BACK of this sheet)

Name of Plugging Contractor R & S Pipe Pulling Company  
Address Box 192, Ellinwood, Kansas

STATE OF Kansas, COUNTY OF Sedgwick, ss.  
Thomas M. McCaul (employee of owner) or (owner or operator) of the above-described well, being first duly sworn on oath, says: That I have knowledge of the facts, statements, and matters herein contained and the log of the above-described well as filed and that the same are true and correct. So help me God.

(Signature) Thomas M. McCaul  
1100 Bitting Building, Wichita, Kansas  
(Address)

SUBSCRIBED AND SWORN to before me this 4th day of March, 1955

My commission expires August 10, 1957

Virginia Mendell  
Notary Public.

PLUGGING  
FILE NO. 8 Twp. 21 R. 12W  
DATE FILED 94 JUNE 22

WELL LOG

ALPINE OIL & ROYALTY CO., INC.  
and L. K. PARRISH

Commenced: 11-23-54

Contractor: Quaker Drilling Co., Inc.

Completed: 2-1-55

Salem No. 1  
SW SW SE Sec. 8-21S-12W  
Stafford County, Kansas

Elevation: 1864 K.B.

Production: D. & A.

Casing Record:

Set 286' of 8 5/8" with 325 sacks cement  
Set 3486' of 5 1/2" with 100 sacks cement

(Figures Indicate the Bottom of Formations)

<u>FORMATIONS</u>	<u>DEPTH</u>	<u>FORMATION TOPS</u>	
Surface Soil	226	Anhydrite	665
Lime & Shale	286	Heebner	3100 -1236
Red Bed & Shale	665	Brown Lime	3230 -1366
Anhydrite	690	Lansing	3245 -1381
Lime and Shale	3045	Arbuckle	3484 -1620
Lime	3180	Total Depth	3534 -1670
Lime and Shale	3260		
Lime	3350		
Lime and Shale	3410		
Lime	3534		

I hereby certify that the above is a true and correct copy of the Drillers Log of the well drilled in the SW SW SE of Section 8, Township 21 South, Range 12 West, Stafford County, Kansas.

QUAKER DRILLING CO., INC.

By: Harold M. M. Carl  
President

SUBSCRIBED AND SWORN to before me this 9th day of February, 19 55.

Virginia Wendell  
Notary Public

My Commission Expires:  
August 10, 1957

RECEIVED  
STATE DEPARTMENT  
MAR 1 1955  
COMMISSIONER OF REVENUE  
WICHITA, KANSAS

PLUGGING  
FILE SEC 8-21-12W  
BOOK PAGE 94 LINE 27