


WELL PLUGGING RECORD

Give All Information Completely
Make Required Affidavit
Mail or Deliver Report to:
Conservation Division
State Corporation Commission
800 Bittling Building
Wichita, Kansas

NORTH

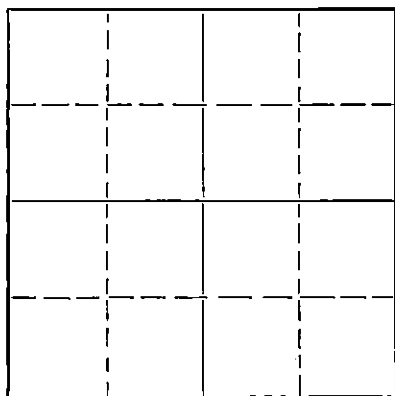

Locate well correctly on above
Section Plat

Stafford County. Sec. 8 Twp. 21 Rge. 12 *(W)* W. (W)
Location as "NE/CNW $\frac{1}{4}$ /SW $\frac{1}{4}$ " or footage from lines NW NE SE
Lease Owner Musgrove Petroleum Corporation, Inc.
Lease Name Salem Well No. 1
Office Address 407 KFH Building, Wichita 2, Kansas
Character of Well (completed as Oil, Gas or Dry Hole) Dry Hole
Date well completed December 30 1951
Application for plugging filed December 30 1951
Application for plugging approved December 30 1951
Plugging commenced December 30 1951
Plugging completed December 30 1951
Reason for abandonment of well or producing formation Dry

If a producing well is abandoned, date of last production 19
Was permission obtained from the Conservation Division or its agents before plugging was commenced? Yes

Name of Conservation Agent who supervised plugging of this well C. D. Stough
Producing formation Depth to top Bottom Total Depth of Well 3580 Feet
Show depth and thickness of all water, oil and gas formations.

OIL, GAS OR WATER RECORDS

CASING RECORD

Formation	Content	From	To	Size	Put In	Pulled Out
Surface				8-5/8"	336'	Cemented

Describe in detail the manner in which the well was plugged, indicating where the mud fluid was placed and the method or methods used in introducing it into the hole. If cement or other plugs were used, state the character of same and depth placed, from feet to feet for each plug set.

Filled hole w/heavy mud to 300'.
Set first plug w/15 sacks cement and
second plug at 30 feet w/10 sacks
cement through the drill pipe.

1-9-52

JAN 6 1952

(If additional description is necessary, use BACK of this sheet)

Name of Plugging Contractor Musgrove Petroleum Corporation, Inc.
Address 407 KFH Building, Wichita 2, Kansas


STATE OF KANSAS, COUNTY OF SEDGWICK, ss.
Gordon L. Koelling (employee of owner) or (owner or operator) of the above-described well,
being first duly sworn on oath, says: That I have knowledge of the facts, statements, and matters herein contained and the log of the above-described well as filed and that the same are true and correct. So help me God.

(Signature) *Gordon L. Koelling*
407 KFH Building, Wichita 2, Kansas
(Address)

SUBSCRIBED AND SWORN to before me this 8th day of January, 1952.

My commission expires July 9, 1952.

Mary Lou Rogers
Notary Public.

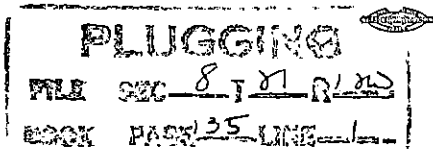

CONTRACTOR'S WELL LOG

COMPANY: Musgrove Petroleum Corporation
 CONTRACTOR: Musgrove Petroleum Corporation
 FARM: Salem #1
 LOCATION: NW NE SE Section 8-21S-12W
 Stafford County, Kansas
 COMMENCED: December 16, 1951
 COMPLETED: December 30, 1951

0	10	Sand
10	35	Shale
35	185	Sand
185	190	Shale
190	336	Shale & anhydrite
336	350	Anhydrite
350	680	Red bed, shells
680	1620	Shale & shells
1620	1875	Lime & shale
1875	1960	Lime
1960	2330	Shale & lime
2330	2500	Shale
2500	2620	Shale & shells
2620	3019	Lime & shale
3019	3035	Lime
3035	3065	Lime & shale
3065	3135	Shale & lime chert
3135	3285	Lime & shale
3285	3425	Lime
3425	3450	Hard lime
3450	3460	Lime
3460	3590	Conglomerate
	3590	Rotary Total Depth

Set 336' of 8-5/8" surface casing, cemented with 200 sacks.

Dry and Abandoned.

STATE OF KANSAS)
) SS:
 COUNTY OF SEDGWICK)

I, GORDON L. KOELLING, do hereby certify that the above and foregoing is a true and correct copy of the log of Salem #1, Section 8-21S-12W, Stafford County, Kansas, as reflected by the files of the Musgrove Petroleum Corporation.

MUSGROVE PETROLEUM CORPORATION

By Gordon L. Koelling
 Secretary-Treasurer

Subscribed and sworn to before me, a Notary Public, within and for Sedgwick County, Kansas, this ninth day of January, 1952.

My Commission expires July 9, 1952.

Ray L. Rogers
 Notary Public

JAN 11 1952

CONTRACTOR'S WELL LOG

COMPANY: Musgrove Petroleum Corporation
 CONTRACTOR: Musgrove Petroleum Corporation
 FARM: Salem #1
 LOCATION: NW NE SE Section 8-21S-12W
 Stafford County, Kansas
 COMMENCED: December 16, 1951
 COMPLETED: December 30, 1951

0	10	Sand
10	35	Shale
35	185	Sand
185	190	Shale
190	336	Shale & anhydrite
336	350	Anhydrite
350	680	Red bed, shells
680	1620	Shale & shells
1620	1875	Lime & shale
1875	1960	Lime
1960	2330	Shale & lime
2330	2500	Shale
2500	2620	Shale & shells
2620	3019	Lime & shale
3019	3035	Lime
3035	3065	Lime & shale
3065	3135	Shale & lime chert
3135	3285	Lime & shale
3285	3425	Lime
3425	3450	Hard lime
3450	3460	Lime
3460	3580	Conglomerate
	3580	Rotary Total Depth

Set 336' of 8-5/8" surface casing, cemented with 200 sacks.

Dry and Abandoned.

STATE OF KANSAS)
) SS:
 COUNTY OF SEDGWICK)

JAN - 9 1952

I, GORDON L. KOELLING, do hereby certify that the above and foregoing is a true and correct copy of the log of Salem #1, Section 8-21S-12W, Stafford County, Kansas, as reflected by the files of the Musgrove Petroleum Corporation.

MUSGROVE PETROLEUM CORPORATION

By Gordon L. Koelling
 Secretary-Treasurer

Subscribed and sworn to before me, a Notary Public, within and for Sedgwick County, Kansas, this fourth day of January, 1952.

My Commission expires July 9, 1952.

Ray L. Royer
 Notary Public

