

STATE OF KANSAS  
STATE CORPORATION COMMISSION

WELL PLUGGING RECORD

Give All Information Completely  
Make Required Affidavit  
Mail or Deliver Report to:  
Conservation Division  
State Corporation Commission  
211 No. Broadway  
Wichita, Kansas

Stafford

County, Sec. 8 Twp. 21s Rge. 12w (E) (W)

Location as "NE/CNW/SW" or footage from lines C SW SE SE

Lease Owner S. A. Murphy

Lease Name Salem Well No. 2

Office Address 712 Brown Bldg. Wichita, Kans 67202

Character of Well (completed as Oil, Gas or Dry Hole) Dry hole

Date well completed November 3, 1964 19

Application for plugging filed " 19

Application for plugging approved " 19


Plugging commenced " 19

Plugging completed " 19

Reason for abandonment of well or producing formation

If a producing well is abandoned, date of last production 19

Was permission obtained from the Conservation Division or its agents before plugging was commenced? yes

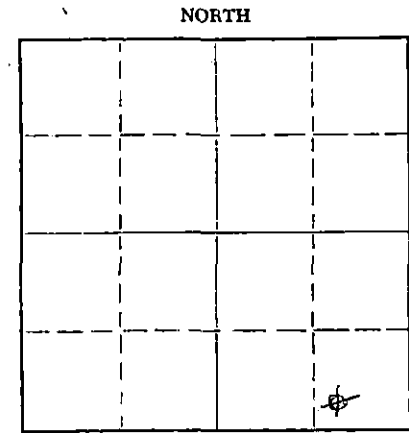

Locate well correctly on above Section Plat

Name of Conservation Agent who supervised plugging of this well Archie Elving

Producing formation Depth to top Bottom Total Depth of Well 3515 Feet

Show depth and thickness of all water, oil and gas formations.

OIL, GAS OR WATER RECORDS

CASING RECORD

FORMATION	CONTENT	FROM	TO	SIZE	PUT IN	PULLED OUT
		0	277	8 5/8"	277	none

Describe in detail the manner in which the well was plugged, indicating where the mud fluid was placed and the method or methods used in introducing it into the hole. If cement or other plugs were used, state the character of same and depth placed, from feet to feet for each plug set.

Mudded to 260 ft - set plug w/25 sx cement 1/4 sx hulls  
Mudded to 40 ft - set plug w/10 sx cement

RECEIVED  
STATE CORPORATION COMMISSION

NOV 12 1964

CONSERVATION DIVISION  
Wichita, Kansas

(If additional description is necessary, use BACK of this sheet)  
Name of Plugging Contractor Virginia Drilling Co., Inc.  
Address 712 Brown Bldg. Wichita, Kans 67202

STATE OF Kansas, COUNTY OF Sedgwick, ss.  
S. A. Murphy (employee of owner) or (owner or operator) of the above-described well, being first duly sworn on oath, says: That I have knowledge of the facts, statements, and matters herein contained and the log of the above-described well as filed and that the same are true and correct. So help me God.

(Signature) S. A. Murphy  
712 Brown Bldg. Wichita, Kans 67202 (Address)

SUBSCRIBED AND SWORN TO before me this 4th day of November 1964

My commission expires Febr. 5, 1965 Notary Public.

9

SALEM # 2 - C SW SE SE Section 8-21s-12w Stafford County, Kansas  
 Company - S. A. Murphy  
 Contractor - Virginia Drilling Co., Inc.  
 Commenced - October 27, 1964  
 Completed - November 3, 1964  
 Elevation - 1956 DF  
 Total Depth - 3515

8 5/8" set at 277 w/250 sx. cem.  
 Dry hole.

FORMATION	DEPTH	TOPS:
Sand - Clay - redbed	0 - 277	
Shale	277 - 395	
Redbed - shale	395 - 1490	3090 - Heebner
Shale-shells	1490 - 1735	3010 - Toronto
Shale-lime	1735 - 1985	3218 - Brn Lime
Lime	1985 - 2115	3233 - Lansing KC
Lime-shale	2115 - 2265	3450 - Base KC
Lime-shale-shells	2265 - 2580	3472 - Simpson Shale
Lime-shale	2580 - 2760	3497 - Arbuckle
Shale	2760 - 2860	
Shale-lime	2860 - 3205	
Lime	3205 - 3515 TD	

*S. A. Murphy*

Subscribed and sworn to before me, a Notary Public, this 4<sup>th</sup> day of November, 1964.

*Murder Saw*  
 Notary Public

My commission expires: 2-5-65

**RECEIVED**  
 STATE CORPORATION COMMISSION  
 NOV. 12 1964  
 CONSERVATION DIVISION  
 Wichita, Kansas