

STATE OF KANSAS
STATE CORPORATION COMMISSION


WELL PLUGGING RECORD

Give All Information Completely
Make Required Affidavit
Mail or Deliver Report to:
Conservation Division
State Corporation Commission
800 Biting Building
Wichita, Kansas

Stafford County, Sec. 29 Twp. 21 Rge. 11 (E) (W)

Location as "NE/CNW/SW" or footage from lines SE SE NE
Lease Owner National Cooperative Refinery Ass'n
Lease Name Smith Estate Well No. 1
Office Address 820 Union National Bank Building, Wichita, Kansas

NORTH

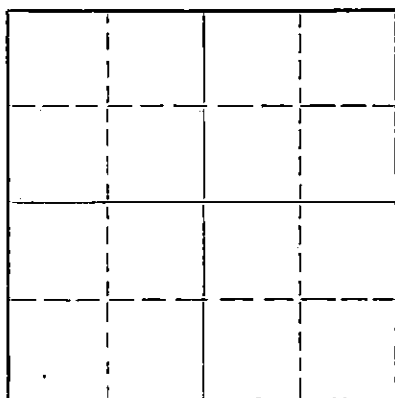

Locate well correctly on above
Section Plat

Character of Well (completed as Oil, Gas or Dry Hole) Dry Hole
Date well completed October 10, 19 53
Application for plugging filed October 12, 19 53
Application for plugging approved October 12, 19 53
Plugging commenced October 10, 19 53
Plugging completed October 10, 19 53
Reason for abandonment of well or producing formation Not capable of commercial production.
If a producing well is abandoned, date of last production 19

Was permission obtained from the Conservation Division or its agents before plugging was commenced? Yes

Name of Conservation Agent who supervised plugging of this well Mr. M. A. Rives
Producing formation Depth to top Bottom Total Depth of Well 3632 Feet
Show depth and thickness of all water, oil and gas formations.

OIL, GAS OR WATER RECORDS

CASING RECORD

FORMATION	CONTENT	FROM	TO	SIZE	PUT IN	PULLED OUT
				8 5/8"	282'	Cemented

Describe in detail the manner in which the well was plugged, indicating where the mud fluid was placed and the method or methods used in introducing it into the hole. If cement or other plugs were used, state the character of same and depth placed, from feet to feet for each plug set.

Mudded hole to 267', set bridge with 1 1/2 gal. hulls plus 20 sx cement. Mudded hole to 40', set bridge with 1 1/2 gal hulls plus 7 sax cement on up to base of cellar.

(If additional description is necessary, use BACK of this sheet)

Name of Plugging Contractor Garvey Drilling Co.
Address 100 Derby Building, Wichita, Kansas.

STATE OF Kansas, COUNTY OF Sedgwick, ss.
C. R. Sears (employee of owner) or (owner or operator) of the above-described well, being first duly sworn on oath, says: That I have knowledge of the facts, statements, and matters herein contained and the log of the above-described well as filed and that the same are true and correct. So help me God.

(Signature) C. R. Sears

(Address)

SUBSCRIBED AND SWORN TO before me this 19 day of October, 19 53

My commission expires June 30, 1954

24-2675-5 2-52-20M

C. Orville May Notary Public.

RECEIVED
STATE CORPORATION COMMISSION

OCT 20 1953

CONSERVATION DIVISION
Wichita, Kansas

PLUGGING
FILE SEC 29 T 21 R 11 W
OK PAGE 135 LINE 2

DRILLER'S LOG SMITH #1

N.C.R.A., Operator

Section 29, Twp. 21S, Rge. 11W

Garvey Drilling Company, Contractor

Location: SE SE NE

Drilling Commenced: September 29, 1953

County: Stafford County, Kansas

Drilling Completed: October 10, 1953

R.T.D.: 3632'

Casing Record: 8 5/8" @ 282.93 w/150 sax

Elevation: 1959' R.B.

Figures below indicate bottom of formation:

70	Sand & Clay
282	Sand & Shale
475	Red Bed
490	Anhydrite
1420	Shale & Shells
2225	Lime & Shale
2573	Shale & Shells
2937	Lime & Shale
3050	Lime
3099	Lime & Shale
3425	Conglomerate
3467	Cherty Conglomerate
3632	Shale & Chert
3632	R.T.D.

I hereby certify that this is a true and correct log of the above mentioned well.

GARVEY DRILLING COMPANY

By

W.W. Fisher

STATE OF KANSAS)
) SS:
COUNTY OF SEDGWICK)

Subscribed to and sworn to before me, a Notary Public, in said County and State, this 14th day of October, 1953.

RECEIVED
NOTARY COMMISSION

Charlotte Heidman
Notary Public

My commission expires: October 13, 1954

OCT 23 1953

REGISTRATION DIVISION
Topeka, Kansas

PLUGGING
FILE SEC 29 T 21 R 4W
BOOK PAGE 135 LINE 7