


STATE OF KANSAS
STATE CORPORATION COMMISSION

WELL PLUGGING RECORD

Give All Information Completely
Make Required Affidavit
Mail or Deliver Report to:
Conservation Division
State Corporation Commission
212 No. Market
Wichita, Kansas

NORTH

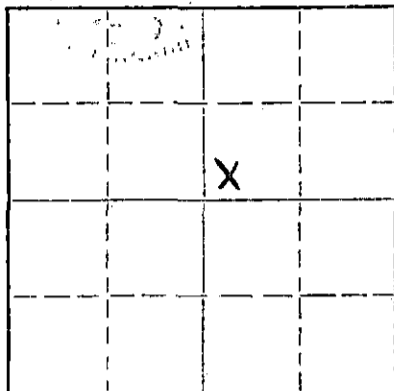

Locate well correctly on above
Section Plat

Rice County. Sec. 3 Twp. 21S Rge. 9 (E) W (W)
Location as "NE/CNW%SW%" or footage from lines SW SW NE
Lease Owner Rains & Williamson Oil Co., Inc.
Lease Name Shuyler Well No. #1
Office Address 1425 Wichita Plaza; Wichita, Kansas 67202
Character of Well (completed as Oil, Gas or Dry Hole) Oil
Date well completed November 8 19 61
Application for plugging filed April 18 19 69
Application for plugging approved April 22 19 69
Plugging commenced June 2 19 69
Plugging completed June 5 19 69
Reason for abandonment of well or producing formation Not economically
feasible to continue producing.
If a producing well is abandoned, date of last production April 24 19 69
Was permission obtained from the Conservation Division or its agents before plugging was commenced? Yes

Name of Conservation Agent who supervised plugging of this well Hugh Scott
Producing formation _____ Depth to top _____ Bottom _____ Total Depth of Well 3482 Feet
Show depth and thickness of all water, oil and gas formations.

OIL, GAS OR WATER RECORDS

CASING RECORD

FORMATION	CONTENT	FROM	TO	SIZE	PUT IN	PULLED OUT
				8 5/8	265	None
				5 3/8	3015	2317
RECEIVED STATE CORPORATION COMMISSION AUG 20 1970 CONSERVATION DIVISION Wichita, Kansas						

Describe in detail the manner in which the well was plugged, indicating where the mud fluid was placed and the method or methods used in introducing it into the hole. If cement or other plugs were used, state the character of same and depth placed, from _____ feet to _____ feet for each plug set.

6 - 2 - 69 Dumped sand to 2930'. Mixed and dumped 5 sx of cement to 2890'.
6 - 5 - 69 Mixed and pumped 5 sx of gel at 600'.
Mixed and pumped 25 sx of cement at 500'.
Mixed and pumped 5 sx of gel at 350'.
Mixed and pumped 25 sx of cement at 250'.
Set 10' rock bridge from 40' to 30'.
Mixed and dumped 10 sx of cement from 30' to base of cellar.

Finished plugging at 11:00 A.M.


(If additional description is necessary, use BACK of this sheet)

Name of Plugging Contractor Russ Casing Pulling, Inc.
Address P. O. Box 1082 Great Bend, Kansas 67530

STATE OF KANSAS, COUNTY OF SEDGWICK, ss.
Wilson Rains (employee of owner) or (owner or operator) of the above-described well, being first duly sworn on oath, says: That I have knowledge of the facts, statements, and matters herein contained and the log of the above-described well as filed and that the same are true and correct. So help me God.

(Signature) Wilson Rains
Wilson Rains
1425 Wichita Plaza, Wichita, Kansas
(Address)

SUBSCRIBED AND SWORN to before me this 19 day of August, 19 70
Jeanine Durand
Jeanine Durand Notary Public.

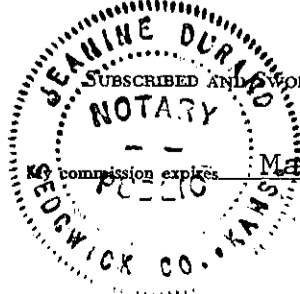

Shuyler #1 - Renfro Drilling Company
SW SW NE Section 3-21S-9W
Rice County, Kansas

Date Commenced - October 30, 1961
Date Completed - November 8, 1961
Elevation - 1678.17
Casing - 265' of 8-5/8" with 300 sacks of cement
Completed at 6 p.m. on October 30, 1961

DRILLERS LOG

0 - 200	Shale, Sand & Red Bed		
200 - 265	Red Bed		
265 - 290	Shale		
290 - 760	Shale		
760 - 1180	Shale		
1180 - 1335	Lime/Shale	<u>Tops</u>	
1335 - 1550	Lime		
1550 - 1800	Lime	Hebner	2764
1800 - 1970	Lime/Shale	Toronto	2780
1970 - 2290	Lime/Shale	Douglas	2798
2290 - 2500	Lime/Shale	Brown Lime	2898
2500 - 2645	Lime/Shale	Lansing-Kansas City	2928
2645 - 2736	Lime/Shale	Base-Kansas City	3232
2736 - 2930	Lime/Shale	Detritial Zone	3287
2930 - 2963	Lime/Shale	Viola	3321
2963 - 3020	Lime	Simpson Shale	3364
3020 - 3081	Lime	Simpson Sand	3373
3081 - 3140	Lime	Arbuckle	3432
3140 - 3212	Lime	Total Depth	3482
3212 - 3295	Lime		
3295 - 3335	Lime		
3335 - 3360	Lime		
3360 - 3375	Lime		
3375 - 3435	Simpson		
3435 - 3482	Arbuckle		
3482 -	Total Depth (T.D.)		

RECEIVED
STATE CORPORATION COMMISSION
APR 21 1969
CONSERVATION DIVISION
Wichita, Kansas

STATE OF KANSAS)
) ss
SEDGWICK COUNTY)

I, the undersigned, being duly sworn on oath, state that the above Drillers Log is true and correct to the best of my knowledge and belief and according to the records of this office.

RENFRO DRILLING COMPANY

By _____

Subscribed and sworn before me this 15th day of November, 1961.

Notary Public

My Commission expires February 27, 1965