


Give All Information Completely
Make Required Affidavit
Mail or Deliver Report to:
Conservation Division
State Corporation Commission
212 No. Market
Wichita, Kansas

WELL PLUGGING RECORD

15-051-20001-00-00

NORTH

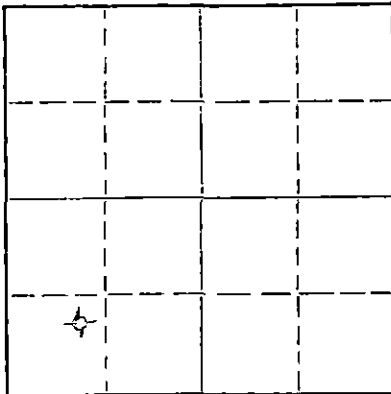

Locate well correctly on above
Section Plat

Ellis County, Sec. 14 Twp. 15S Rge. (E) 17W
Location as "NE/CNW/SW" or footage from lines. NE 1/4 SW 1/4 SW 1/4
Lease Owner Birmingham-Bartlett Drilling Co.
Lease Name Roth 'A' Well No. 1
Office Address 300 Kaufman Building, Wichita, Kansas, 67202
Character of Well (completed as Oil, Gas or Dry Hole) Dry Hole
Date well completed January 14, 1967
Application for plugging filed (verbally approved 1st) January 16, 1967
Application for plugging approved (verbally approved) 19
Plugging commenced January 14, 1967
Plugging completed January 14, 1967
Reason for abandonment of well or producing formation

If a producing well is abandoned, date of last production 19
Was permission obtained from the Conservation Division or its agents before plugging was commenced? Yes

Name of Conservation Agent who supervised plugging of this well Leo F. Massey
Producing formation Depth to top Bottom Total Depth of Well 3600 Feet
Show depth and thickness of all water, oil and gas formations.

OIL, GAS OR WATER RECORDS

CASING RECORD

FORMATION	CONTENT	FROM	TO	SIZE	PUT IN	PULLED OUT
		0	1126'	8-5/8	1126'	None

Describe in detail the manner in which the well was plugged, indicating where the mud fluid was placed and the method or methods used in introducing it into the hole. If cement or other plugs were used, state the character of same and depth placed, from feet to feet for each plug set.

2 plugs at 480' with 30 sacks cement. Filled with mud to 40' and plugged with 10 sacks cement

RECEIVED
STATE CORPORATION COMMISSION
JAN 28 1967
1-17-67
CONSERVATION DIVISION
Wichita, Kansas

(If additional description is necessary, use BACK of this sheet)
Name of Plugging Contractor Birmingham-Bartlett Drilling Co.
Address 300 Kaufman Bldg., Wichita, Kansas

STATE OF KANSAS, COUNTY OF SEDGWICK
Richard Hindery, partner of Birmingham-Bartlett Drilling Co., owner & operator of the above-described well, being first duly sworn on oath, says: That I have knowledge of the facts, statements, and matters herein contained and the log of the above-described well as filed and that the same are true and correct. So help me God. BIRMINGHAM-BARTLETT DRILLING CO.
(Signature) By Richard Hindery Partner
300 Kaufman Bldg., Wichita, Kansas, 67202 (Address)

SUBSCRIBED AND SWORN TO before me this 16th day of January 1967

Vivian F. Yinger Notary Public

My commission expires November 29, 1970.

ROTH "A" NO. 1 WELL

LOCATION: NE $\frac{1}{4}$ SW $\frac{1}{4}$ SW $\frac{1}{4}$ Sec. 14-15S-17W
Ellis County, Kansas

SPUDED: 1-5-67

DRILLING FINISHED: 1-14-67

OWNER, OPERATOR
and CONTRACTOR: Birmingham-Bartlett Drilling Co.
300 Kaufman Building
Wichita, Kansas, 67202

SURFACE CASING: 8-5/8" 20# surface casing set at
1126' with 265 sacks common with 2%
gel and 2% chloride and 250 sacks
Sunset cement.

OIL STRING: None Run - Dry & Abandoned

LOG

(Figures indicate bottom of formation)

0 -	40	Shale
	70	Shale & Rock
	350	Shale & Shells
	400	Sand
	520	Shale & Shells
	760	Sand
	880	Shale
	1117	Red Bed
	1159	Anhydrite
	1615	Red Bed & Shale
	1950	Shale & Shells
	2586	Lime and Shale
	2790	Shale
	3125	Lime and Shale
	3600	Lime
	3600	Rotary Total Depth

RECEIVED
STATE GEOLOGICAL AND COMMISSION
JAN 17 1967
CORRELATION DIVISION
Wichita, Kansas

The undersigned, Richard Hindery, one of the partners of Birmingham-Bartlett Drilling Co., hereby certifies that the above is a true and correct log of the ROTH "A" NO. 1 WELL, as shown in the daily drilling reports.

BIRMINGHAM-BARTLETT DRILLING CO.

By

Richard Hindery
Richard Hindery, Partner

Subscribed and sworn to before me
this 16th day of January, 1967.

Vivian F. Yinger

Vivian F. Yinger, Notary Public

My commission expires November 29, 1970.