


WELL PLUGGING RECORD

Give All Information Completely
Make Required Affidavit
Mail or Deliver Report to:
Conservation Division
State Corporation Commission
800 Biting Building
Wichita, Kansas

NORTH

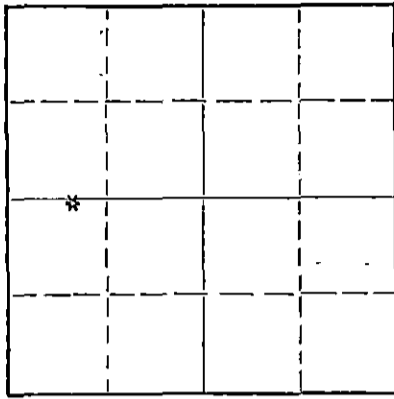

Locate well correctly on above
Section Flat

Pawnee County. Sec. 32 Twp. 23 Rge. 15 (E) (W)
Location as "NE/CNW/SW" or footage from lines Center of N. line NE NW SW
Lease Owner H. W. Muir and Ben M. Giles
Lease Name Hall B Well No. 2
Office Address 2727 N. Main Hutchinson, Kansas
Character of Well (completed as Oil, Gas or Dry Hole) Dry hole
Date well completed April 16 19 56
Application for plugging filed April 16 19 56
Application for plugging approved April 16 19 56
Plugging commenced April 16 19 56
Plugging completed 10:00 p.m. April 16 19 56
Reason for abandonment of well or producing formation Dry hole

If a producing well is abandoned, date of last production 19
Was permission obtained from the Conservation Division or its agents before plugging was commenced? Yes

Name of Conservation Agent who supervised plugging of this well R. M. Brundege
Producing formation Depth to top Bottom Total Depth of Well 3853 Feet
Show depth and thickness of all water, oil and gas formations.

OIL, GAS OR WATER RECORDS

CASING RECORD

FORMATION	CONTENT	FROM	TO	SIZE	PUT IN	PULLED OUT
Surface Pipe		-0-	220	8 5/8"	220	-0-

Describe in detail the manner in which the well was plugged, indicating where the mud fluid was placed and the method or methods used in introducing it into the hole. If cement or other plugs were used, state the character of same and depth placed, from feet to feet for each plug set.

Pumped heavy mud to bottom.
Filled hole with heavy mud to 210'.
Pushed plug to 210' with hulls underneath.
Dumped 20 sacks cement through drill pipe.
Filled to 35'. Dumped 1/3 sack hulls.
Pushed plug to 35'.
Filled to bottom of cellar with 10 sacks cement.

RECEIVED
4-24-56
APR 24 1956
CONSERVATION DIVISION
Wichita, Kansas

(If additional description is necessary, use BACK of this sheet)
Name of Plugging Contractor A. L. Jackson Drilling Company
Address Box 194 Great Bend, Kansas

STATE OF Kansas, COUNTY OF Barton, ss.
A. L. Jackson, drilling contractor on (employee of owner) or (owner or operator) of the above-described well, being first duly sworn on oath, says: That I have knowledge of the facts, statements, and matters herein contained and the log of the above-described well as filed and that the same are true and correct. So help me God.

(Signature) A. L. Jackson
Box 194 Great Bend, Kansas
(Address)

SUBSCRIBED AND SWORN TO before me this 18th day of April, 19 56

M. B. Casius

My commission expires May 9, 1959

Notary Public.

PLUGGING
FILE SEC 32 T 23 R 15W
BOOK PAGE 55 LINE 3

Well Log
Hall D-2
Center of N. Line
NE NW SW 32-23-15
Pawnee County, Kansas

15-145-01022-0000

0 - 45	Surface clay - water sand
45 - 100	Water sand
100 - 190	Sand and shale
190 - 220	Blue shale
220 - 330	Shale - shells
330 - 940	Red bed - shale
940 - 975	Anhydrite
975 - 1280	Shale and shells
1280 - 1420	Lime and shale
1420 - 1500	Shale and shells
1500 - 1555	Salt
1555 - 1795	Shale - shells
1795 - 1890	Lime and shale
1890 - 2105	Lime
2105 - 2410	Lime - shale
2410 - 3230	Shale - lime
3230 - 3470	Lime
3470 - 3590	Lime - shale
3590 - 3600	Brown lime
3600 - 3605	Lime, K. C.
3605 - 3853	Lime
3853	T. D.

STATE OF KANSAS

COUNTY OF BARTON ss

A. L. Jackson, owner of A. L. Jackson Drilling Company, being first duly sworn on oath says: That I have knowledge of the facts, statements, and matters herein contained and the log of the above described well as filed and that the same are true and correct.

A. L. Jackson

A. L. Jackson

Subscribed and sworn before me this 18th day of April, 1956.

Dick B. Evans

Dick B. Evans

Notary Public Barton County

My Commission expires May 9, 1959

RECEIVED
STATE CORPORATION COMMISSION

APR 24 1956

CONSERVATION DIVISION
Wichita, Kansas

PLUGGING
FILE SEC 32 T 23 R 15 W
BOOK PAGE 26 LINE 3