


WELL PLUGGING RECORD

Give All Information Completely
Make Required Affidavit
Mail or Deliver Report to:
Conservation Division
State Corporation Commission
800 Bittling Building
Wichita, Kansas

NORTH

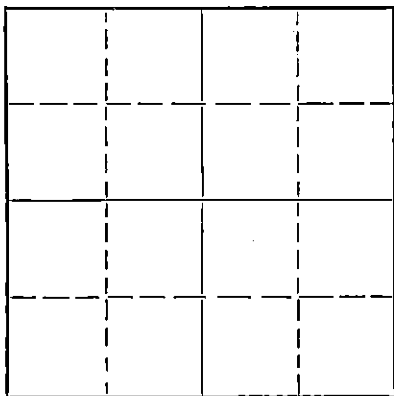

Locate well correctly on above
Section Plat

Pawnee County. Sec. 32 Twp. 23 Rge. 15 (E) W. (W)
Location as "NE/CNW $\frac{1}{4}$ SW $\frac{1}{4}$ " or footage from lines 330' N. & 330' E. of Center
Lease Owner Cities Service Oil Company
Lease Name Frick Well No. 3
Office Address Bartlesville, Oklahoma
Character of Well (completed as Oil, Gas or Dry Hole) Dry Hole
Date well completed March 12, 1953
Application for plugging filed March 12, 1953
Application for plugging approved March 12, 1953
Plugging commenced March 12, 1953
Plugging completed March 12, 1953
Reason for abandonment of well or producing formation Dry Hole

If a producing well is abandoned, date of last production --- 19---
Was permission obtained from the Conservation Division or its agents before plugging was commenced? Yes

Name of Conservation Agent who supervised plugging of this well Ruel Durkee
Producing formation --- Depth to top --- Bottom --- Total Depth of Well 3880 Feet
Show depth and thickness of all water, oil and gas formations.

OIL, GAS OR WATER RECORDS

CASING RECORD

Formation	Content	From	To	Size	Put In	Pulled Out
				8-5/8"	405'	None

Describe in detail the manner in which the well was plugged, indicating where the mud fluid was placed and the method or methods used in introducing it into the hole. If cement or other plugs were used, state the character of same and depth placed, from --- feet to --- feet for each plug set.

3880-250' heavy mud,
250-190' wood plug and hulls bridge and 20 sacks cement
190- 20' mud
20' to base of cellar, 5 sacks cement.

3-19-53

(If additional description is necessary, use BACK of this sheet)

Name of Plugging Contractor Barbour Drilling Company
Address Tulsa, Oklahoma

STATE OF Kansas, COUNTY OF Barton, ss.
V. M. Conover (employee of owner) or Owner or operator of the above-described well,
being first duly sworn on oath, says: That I have knowledge of the facts, statements, and matters herein contained and the log of the above-described well as filed and that the same are true and correct. So help me God.


(Signature) V. M. Conover

Box 751, Great Bend, Kansas
(Address)

SUBSCRIBED AND SWORN to before me this 13th day of March 19 53

N. G. Smith
Notary Public.

My commission expires March 12, 1955.

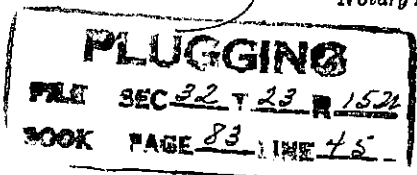

WELL RECORD

15-145-01020-0500

Company Cities Service Oil Co. Well No. 3 Farm Frick
 Location 330' North and 330' East of Center Sec. 32 T. 23 R. 15W
 Elevation 2031 (2029 Gr.) County Pawnee State Kansas
 Drlg. Comm. February 25, 1953 Contractor Barbour Drilling Company
 Drlg. Comp. March 11, 1953 Acid None
 T. D. 3880' Initial Prod. Dry Hole - P. & A. 3-11-53

CASING RECORD:

8-5/8" @ 405' cas. 225 ex cement

FORMATION RECORD:

sand & shale	0-250
shale & shells	360
red bed & shales	401
red bed, sand & shale	840
shale	985
anhydrite	1010
shale & shells	1805
lime & shale	2220
lime	2475
lime & shale	2540
shale & lime	2625
lime	2695
lime & shale	2790
shale & lime	2925
lime & shale	3080
lime	3300
broken lime	3360
lime	3575
shale & lime	3619
lime	3865
lime & shale	3880 T. D.

Heebner	3475'
Brown Limestone	3607'
Lansing	3617'
Base Kansas City	3862'
Total Depth	3880'

Drill stem test 3618-51, open 1 hr., recovered 64' muddy water; B. H. P. 1050#/15 mins.

Drill stem test 3761-97, open 1 hr., recovered 480' gas-cut mud and water with slight show oil, 170' water and oil (70% water) and 20' salt water; B. H. P. 1020#/15 mins.

SYFO:	1000'	0°
	1500'	0°
	2000'	1°
	3000'	1°

PLUGGING

FILE SEC 32 T 23 R 15W
 BOOK PAGE 83 LINE 45

RECEIVED
 STATE CORPORATION COMMISSION
 MAR 19 1953
 DIVISION
 STATE OF KANSAS