

15-145-20302-0000


STATE OF KANSAS  
STATE CORPORATION COMMISSION

Form CP-4

Give All Information Completely  
Make Required Affidavit  
Mail or Deliver Report to:  
Conservation Division  
State Corporation Commission  
212 No. Market  
Wichita, Kansas

WELL PLUGGING RECORD

Pawnee County. Sec. 33 Twp. 23S Rge. (E) 15 (W)  
Location as "NE/CNW/SW" or footage from lines C NW/4  
Lease Owner Northern Natural Gas Company  
Lease Name Becker Well No. #2  
Office Address P. O. Box 872, Woodward, Oklahoma 73801  
Character of Well (completed as Oil, Gas or Dry Hole) dry hole  
Date well completed November 27 1973  
Application for plugging filed October 15 1975  
Application for plugging approved October 16, 1975  
Plugging commenced October 20 1975  
Plugging completed October 22 1975  
Reason for abandonment of well or producing formation dry

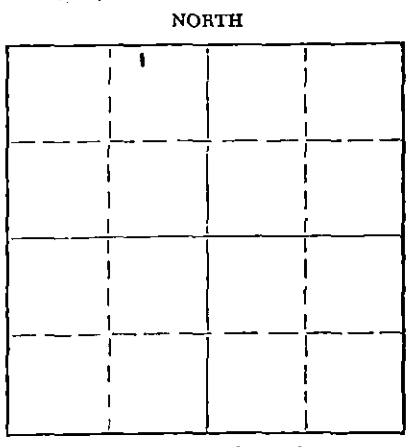

Locate well correctly on above Section Plat

If a producing well is abandoned, date of last production \_\_\_\_\_ 19\_\_\_\_  
Was permission obtained from the Conservation Division or its agents before plugging was commenced? yes

Name of Conservation Agent who supervised plugging of this well Leo Massey  
Producing formation \_\_\_\_\_ Depth to top \_\_\_\_\_ Bottom \_\_\_\_\_ Total Depth of Well 2,165 Feet  
Show depth and thickness of all water, oil and gas formations.

OIL, GAS OR WATER RECORDS

CASING RECORD

FORMATION	CONTENT	FROM	TO	SIZE	PUT IN	PULLED OUT
				4 1/2"	2,164'	1,480'

Describe in detail the manner in which the well was plugged, indicating where the mud fluid was placed and the method or methods used in introducing it into the hole. If cement or other plugs were used, state the character of same and depth placed, from \_\_\_\_\_ feet to \_\_\_\_\_ feet for each plug set.

Plug @ 1,975', Sand bridge 1,950'. Mixed and dumped  
4 sx. common cement w/bailer.  
Mixed and pumped 2 sx. hulls, 15 sx. gel, and 100 sx.  
common cement down 8 5/8".

RECEIVED  
STATE CORPORATION COMMISSION

NOV 7 1975

CONSERVATION DIVISION  
OFFICE WITH RECORDS  
WICHITA, KANSAS

11-7-75

(If additional description is necessary, use BACK of this sheet)

Name of Plugging Contractor Pawnee Well Service, Inc.  
Address P. O. Box 783, Great Bend, Kansas 67530


STATE OF KANSAS, COUNTY OF BARTON, SS.  
Robert L. Pelster (employee of owner) or (owner or operator) of the above-described well, being first duly sworn on oath, says: That I have knowledge of the facts, statements, and matters herein contained and the log of the above-described well as filed and that the same are true and correct. So help me God.

(Signature) [Signature]  
Robert L. Pelster  
P. O. Box 783, Great Bend, Kansas 67530  
(Address)

SUBSCRIBED AND SWORN TO before me this 5th day of November, 1975

My commission expires December 30, 1978

[Signature]  
Arlene Bailey  
Notary Public.

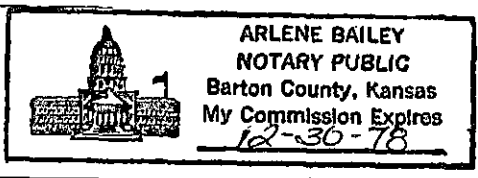

15-145-20302-0000

STERLING DRILLING COMPANY  
P. O. Box 129  
Sterling, Kansas 67579

WELL LOG ----- BECKER #2  
Located: C NW/4, Section 33-23S-15W, Pawnee County, Kansas

OWNER: Aspen Drilling Company  
ROTARY DRILLING CONTRACTOR: Sterling Drilling Company

COMMENCED: August 22, 1973  
COMPLETED: August 27, 1973

TOTAL DEPTH: 2165'

<u>LOG</u>	<u>CASING RECORD</u>
0 - 260 Sand and Shale	Ran 9 joints 7" used casing, 273.69' set at 272' G.L. with 150 sacks 60-40 Pozmix, 3% cc. Plug down 1:45 AM, 8-23-73.
260 - 885 Shale	
885 - 2158 Lime and Shale	
2158 - 2165 Lime	Ran 56 joints 4 1/2" 9.5# used seamless casing, set at 2164.41' G.L. Cemented with 100 sacks 50-50 Pozmix. Plug down 7:07 PM, 8-27-73.

RECEIVED  
STATE CONSERVATION COMMISSION

OCT 16 1975

CONSERVATION DIVISION  
WICHITA, KANSAS