


15-145-50498-0000

WELL PLUGGING RECORD

Give All Information Completely
Make Required Affidavit
Mail or Deliver Report to:
Conservation Division
State Corporation Commission
212 North Market, Insurance Bldg.
Wichita, Kansas

Pawnee County, Sec. 33 Twp. 23S Rge. 15W (X) (W)
Location as "NE/CNW/SW" or footage from lines NE NW NW
Lease Owner Dunne-Gardner Drilling Co., Inc.
Lease Name Becker Well No. 1
Office Address 300 Schweiter Building, Wichita, Kansas
Character of Well (completed as Oil, Gas or Dry Hole) Dry Hole
Date well completed May 18, 19 62
Application for plugging filed May 18, 19 62
Application for plugging approved May 18, 19 62
Plugging commenced May 18, 19 62
Plugging completed May 18, 19 62
Reason for abandonment of well or producing formation dry

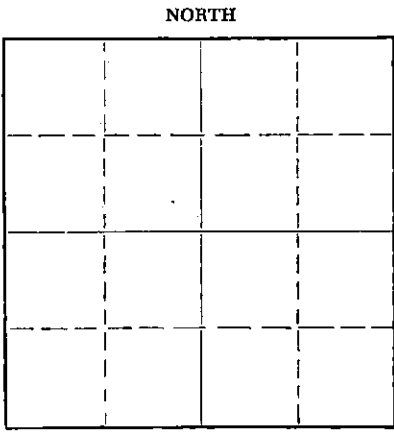

Locate well correctly on above Section Plat

If a producing well is abandoned, date of last production 19
Was permission obtained from the Conservation Division or its agents before plugging was commenced? yes

Name of Conservation Agent who supervised plugging of this well LacCamp
Producing formation _____ Depth to top _____ Bottom _____ Total Depth of Well 3030 Feet
Show depth and thickness of all water, oil and gas formations.

OIL, GAS OR WATER RECORDS				CASING RECORD		
FORMATION	CONTENT	FROM	TO	SIZE	PUT IN	PULLED OUT
Surface Pipe		0	205'	8-5/8"	5-13-62	none

Describe in detail the manner in which the well was plugged, indicating where the mud fluid was placed and the method or methods used in introducing it into the hole. If cement or other plugs were used, state the character of same and depth placed, from _____ feet to _____ feet for each plug set.

Mud to 350', set plug with 25 sacks cement.
Mud to 140', set plug with 1/4 sack hulls and 20 sacks cement. Mud to 35', set plug with 1/4 sack hulls and 10 sacks cement.

RECEIVED
STATE CORPORATION COMMISSION
5-22-62 MAY 22 1962
CONSERVATION DIVISION
Wichita, Kansas

(If additional description is necessary, use BACK of this sheet)
Name of Plugging Contractor Dunne-Gardner Drilling Co., Inc.
Address _____

STATE OF Kansas, COUNTY OF Sedgwick, ss.
Don Gardner (employee of owner) (owner or operator) of the above-described well, being first duly sworn on oath, says: That I have knowledge of the facts, statements, and matters herein contained and the log of the above-described well as filed and that the same are true and correct. So help me God.
(Signature) Don Gardner
300 Schweiter Building, Wichita 2, Kansas
(Address)

SUBSCRIBED AND SWORN TO before me this 21st day of May, 19 62

My commission expires November 9, 1965 Marilyn E. Fox Notary Public.

INVOICED
DATE 5/22/62
INV. NO. 5039-W

DRILLER'S LOG

15-145-00498-0000

OPERATOR: Dunne-Gardner Drilling Co., Inc.
 300 Schweiter Building, Wichita 2, Kansas

LEASE: Becker

WELL: No. 1

LOCATION: NE NW NW Sec. 33-23S-15W
 Pawnee County, Kansas

CONTRACTOR: Dunne-Gardner Drilling Co., Inc.

DATE COMMENCED: May 12, 1962

DATE COMPLETED: May 18, 1962

TOTAL DEPTH: 3030'

CASING: Set 205' of 8-5/8" surface pipe with 190 sacks cement.

RECEIVED
STATE CORPORATION COMMISSION

JUN 1 1962

CONSERVATION DIVISION
Wichita, Kansas

<u>FROM</u>	<u>TO</u>	
0	204	Sand, Clay and Shale
204	947	Shale
947	968	Anhydrite
968	1670	Shale and Shells
1670	3030	Lime and Shale
3030		Total Depth


I certify the above to be true and correct to the best of my knowledge and belief.

DUNNE-GARDNER DRILLING CO., INC.

By 
 Don Gardner

Subscribed and sworn to before me this 22nd day of May, 1962.

My Commission Expires:
November 9, 1965

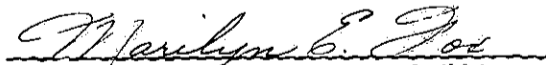
 Marilyn E. Fox, Notary Public

RECEIVED
STATE CORPORATION COMMISSION

JUN 1 1962

CONSERVATION DIVISION
Wichita, Kansas