


15-145-60012-0000

WELL PLUGGING RECORD

Give All Information Completely  
Make Required Affidavit  
Mail or Deliver Report to:  
Conservation Division,  
State Corporation Commission  
800 Bitting Building  
Wichita, Kansas

NORTH

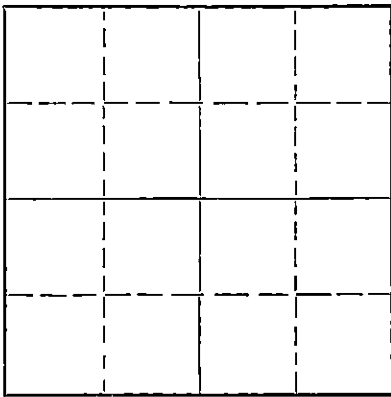

Locate well correctly on above  
Section Plat

Pawnee County, Sec. 33 Twp. 23 Rge. (E) 15 (W)  
Location as "NE/CNW 1/4 SW 1/4" or footage from lines 330' N. & 990' W. of Center  
Lease Owner Cities Service Oil Company  
Lease Name Becker "D" Well No. 1  
Office Address Bartlesville, Oklahoma  
Character of Well (completed as Oil, Gas or Dry Hole) Dry Hole  
Date well completed October 19, 1952  
Application for plugging filed October 19, 1952  
Application for plugging approved October 19, 1952  
Plugging commenced October 19, 1952  
Plugging completed October 19, 1952  
Reason for abandonment of well or producing formation Dry Hole

If a producing well is abandoned, date of last production ----- 19\_\_\_\_  
Was permission obtained from the Conservation Division or its agents before plugging was commenced? Yes

Name of Conservation Agent who supervised plugging of this well M. A. Rives  
Producing formation \_\_\_\_\_ Depth to top \_\_\_\_\_ Bottom \_\_\_\_\_ Total Depth of Well 4160 Feet  
Show depth and thickness of all water, oil and gas formations.

OIL, GAS OR WATER RECORDS

CASING RECORD

Formation	Content	From	To	Size	Put In	Pulled Out
				8-5/8"	381'	None

Describe in detail the manner in which the well was plugged, indicating where the mud fluid was placed and the method or methods used in introducing it into the hole. If cement or other plugs were used, state the character of same and depth placed, from \_\_\_\_\_ feet to \_\_\_\_\_ feet for each plug set.

4160' - 300', mud.  
300' - 265', wood plug and 20 sacks cement.  
265' - 35', mud and sand.  
35' - base of cellar, 10 sacks cement.

RECEIVED  
STATE CORPORATION COMMISSION  
OCT 21 1952  
10-31-52  
CONSERVATION DIVISION  
Wichita, Kansas

(If additional description is necessary, use BACK of this sheet)  
Name of Plugging Contractor Barbour Drilling Company  
Address Tulsa, Oklahoma

STATE OF Kansas, COUNTY OF Barton, ss.  
V. M. Conover (employee of owner) or (owner or proprietor) of the above-described well,  
being first duly sworn on oath, says: That I have knowledge of the facts, statements, and matters herein contained and the log of the above-described well as filed and that the same are true and correct. So help me God.

(Signature) *V. M. Conover*  
Box 751, Great Bend, Kansas  
(Address)

SUBSCRIBED AND SWORN TO before me this 27<sup>th</sup> day of October, 1952.  
*H. G. Smith*  
Notary Public.

My commission expires 3-12-55  
23-8390-s 6-51-20M

PLUGGING  
FILE SEC 23 T 23 R 15 24  
BOOK PAGE 53 LWE 12

# WELL RECORD

15-145-00012-0006

Company: Cities Service Oil Co. Well No. 1 Farm Recker 444  
 Location: 330' North and 990' West of Center Sec. 33 T. 23 R. 15W  
 Elevation: 2026 (2021 Gr.) County Pawnee State Kansas  
 Drlg. Comm. October 3, 1952 Contractor Farbour Drilling Company  
 Drlg. Comp. October 18, 1952 Acid None  
 T. D. 4160' Initial Prod. Dry Hole; Plugged and abandoned 10-19-52.

CASING RECORD:

8-5/8" @ 375' com. w/ 200 sz cement

FORMATION RECORD:

sand & clay	0-145
shale & shells	375
red bed & shale	430
sand	485
shale, red bed & shells	590
red bed	945
anhydrite	970
shale & shells	1665
lime & shale	2465
shale	2520
lime & shale	2700
shale & lime	2780
lime & shale	2955
lime	3050
lime & shale	3150
lime	3530
lime & shale	3653
lime	3974
cherty lime	4003
lime & shale	4010
lime	4045
cherty lime	4087
lime & shale	4160 T. D.

Brown Limestone	3637'
Lancing	3646'
Viola	3976'
Simpson	4101'
Artuckle	4144'
Penetration	16'
Total Depth	4160'

Drill stem test 4146-60, open 1 hr., recovered 2610' sulphur water; S. H. P. 1320# in 15 mins.

SLOPE TESTS (TOTCO):

375'	1/2°
1000'	1/2°
1500'	1/4°
2000'	1/2°
2500'	3/4°
3000'	1°
3500'	1°
4000'	1-1/4°

PLUGGING

FILE SER. 33722R-154

BOOK PAGE 62 LINE 62

RECEIVED

STATE CORPORATION COMMISSION

OCT 3 1 1952

CONSERVATION DIVISION  
Wichita, Kansas