

15-145-19054-0000

STATE OF KANSAS
STATE CORPORATION COMMISSION

WELL PLUGGING RECORD

Give All Information Completely
Make Required Affidavit
Mail or Deliver Report to:
Conservation Division
State Corporation Commission
800 Biting Building
Wichita, Kansas

Pawnee County. Sec. 24 Twp. 23 Rge. 15 (W)

Location as "NE/CNW/SW" or footage from lines NW/4 NW/4 NE/4

Lease Owner D & M Drilling Company, Inc.

Lease Name Greenwood Well No. 1

Office Address P. O. Box 247, Great Bend, Kansas

Character of Well (completed as Oil, Gas or Dry Hole) Dry Hole

Date well completed 4/2 19 55

Application for plugging filed 4/4 19 55

Application for plugging approved 4/1 19 55


Plugging commenced 4/2 19 55

Plugging completed 4/2 19 55

Reason for abandonment of well or producing formation Dry Hole

If a producing well is abandoned, date of last production _____ 19 _____

Was permission obtained from the Conservation Division or its agents before plugging was commenced? Yes

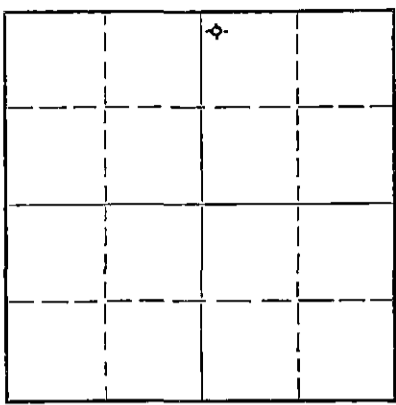

Locate well correctly on above Section Plat

Name of Conservation Agent who supervised plugging of this well Warren Horner

Producing formation _____ Depth to top _____ Bottom _____ Total Depth of Well 4234 Feet

Show depth and thickness of all water, oil and gas formations.

OIL, GAS OR WATER RECORDS

CASING RECORD

FORMATION	CONTENT	FROM	TO	SIZE	PUT IN	PULLED OUT
TD drilled to Arbuckle				8 5/8	211	

Describe in detail the manner in which the well was plugged, indicating where the mud fluid was placed and the method or methods used in introducing it into the hole. If cement or other plugs were used, state the character of same and depth placed, from _____ feet to _____ feet for each plug set.

Filled up with heavy mud to 200', Halliburton plug at 200', 1/3 sack hulls, 20 sacks cement, filled with heavy mud to 35', Halliburton plug, 1/3 sack hulls, and 10 sacks cement.

(If additional description is necessary, use BACK of this sheet)

Name of Plugging Contractor D & M Drilling Company, Inc.

Address P. O. Box 247, Great Bend, Kansas

STATE OF Kansas, COUNTY OF Barton, ss.

W. M. Barnett (employee of owner) or (owner or operator) of the above-described well, being first duly sworn on oath, says: That I have knowledge of the facts, statements, and matters herein contained and the log of the above-described well as filed and that the same are true and correct. So help me God.

(Signature) W. M. Barnett

P. O. Box 247, Great Bend, Kansas
(Address)

SUBSCRIBED AND SWORN TO before me this 4th day of April, 19 55

My commission expires July 29, 1957

James Lewney Notary Public.

24-7968-S 3-53-20M

PLUGGING
REC 24 T 23 R 150
PAGE 109 LINE 12

RECEIVED
STATE CORPORATION COMMISSION
APR 7 1955
4-7-55
CONSERVATION DIVISION
Wichita, Kansas

GREENWOOD #1

15-145-19054-0000

NW/4, NW/4, NE/4 of Section 34-23S-15W Pawnee County, Kansas

Rigged up Rotary Tools 3/22/55

Ran 9 Jts. (212.64') 8 5/8" 32# Casing set at 211'. Cemented with 150 sacks cement.

Tore down Rotary Tools 4/2/55

<u>FORMATION</u>	<u>FROM</u>	<u>TO</u>
Clay & sand	0'	129'
Shale & shells	129	211
Shale	211	250
Shale & sand	250	470
Redbed & shale	470	935
Anhydrite	935	1198
Shale & shells	1198	1375
Shale & salt	1375	1480
Shale & lime streaks	1480	1700
Shale & lime	1700	1895
Lime & shale streaks	1895	2042
Lime	2042	2130
Lime & shale	2130	2455
Shale & Brown Lime	2455	2575
Shale & lime streaks	2575	3110
Sandy shale & lime	3110	3249
Lime & shale streaks	3249	3420
Lime & shale	3420	3512
Lime & shale streaks	3512	3597
Lime & shale	3597	3717
Lime	3717	3945
Lime & chert	3945	4056
Conglomerate & chert	4056	4104
Chert	4104	4112
Lime & chert	4112	4130
Lime & shale	4130	4139
Lime	4139	4145
Shale	4145	4188
Lime	4188	4200
Arbuckle	4200	4234 TD

I, W. M. Barnett, do hereby certify that the foregoing log is true and correct, to the best of my knowledge and belief.

W. M. Barnett

Subscribed and sworn to before me this 6th day of April, 1955

James Swanson

My commission expires: July 29, 1957

PLUGGING
 FILE SEC 24 T 23 R 15 W
 BOOK PAGE 109 LINE 11