


STATE OF KANSAS
STATE CORPORATION COMMISSION

WELL PLUGGING RECORD

15-145-20579-0000

Give All Information Completely.
Make Required Affidavit
Mail or Deliver Report to
Conservation Division
State Corporation Comm.
245 North Water
Wichita, KS 67202

Pawnee County, Sec. 34 Twp. 23 Rge. 15 E/W
Location as "NE/CNW $\frac{1}{4}$ SW $\frac{1}{4}$ " or footage from lines
NE NW NW
Lease Owner Woodman & Iannitti Drilling Co.
Lease Name Preston Well No. 1
Office Address 1008 Douglas Bldg. 104 S. Broadway
Character of Well (Completed as Oil, Gas or Dry Hole)

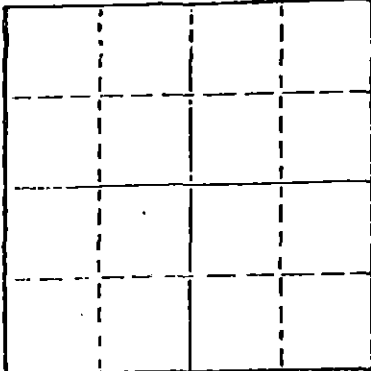

Locate well correctly on above
Section Plat

Dry Hole
Date Well completed March 30 19 79
Application for plugging filed March 30 19 79
Application for plugging approved March 30 19 79
Plugging commenced March 30 19 79
Plugging completed March 30 19 79
Reason for abandonment of well or producing formation
dry hole

If a producing well is abandoned, date of last production 19

Was permission obtained from the Conservation Division or
its agents before plugging was commenced? yes

Name of Conservation Agent who supervised plugging of this well Leo Massey
Producing formation Depth to top Bottom Total Depth of Well 4200
Show depth and thickness of all water, oil and gas formations.

OIL, GAS OR WATER RECORDS

CASING RECORD

FORMATION	CONTENT	FROM	TO	SIZE	PUT IN	PULLED OUT
				8 5/8	346	

Describe in detail the manner in which the well was plugged, indicating where the mud fluid
was placed and the method or methods used in introducing it into the hold. If cement or other
plugs were used, state the character of same and depth placed, from feet to
feet for each plug set.

1st plug 420 w/50 sx.

2nd plug 240 w/25 sx.

3rd plug 40 w/10 sx.

RECEIVED
STATE CORPORATION COMMISSION

APR - 9 1979

(If additional description is necessary, use BACK of this sheet)
Name of Plugging Contractor Woodman & Iannitti Drilling Co. Conservation Division
Wichita, Kansas

STATE OF KANSAS COUNTY OF SEDGWICK, ss.
K. T. Woodman (employee of owner) or (owner or operator)
of the above-described well, being first duly sworn on oath, says: That I have knowledge of
the facts, statements, and matters herein contained and the log of the above-described well
as filed and that the same are true and correct. So help me God.

(Signature)

K. T. Woodman

1008 Douglas Bldg. 104 S. Broadway
(Address)

SUBSCRIBED AND SWORN TO before me this 4th day of April, 19 79

My commission expires Feb. 11, 1980

Justina Chamberlain
Justina Chamberlain Notary Public.

K. T. WOODMAN
RES. PHONE 733-0418
OFF. PHONE 265-7650
WICHITA, KANSAS

D. J. IANNITTI
PHONE 792-2921
GREAT BEND, KANSAS

WOODMAN & IANNITTI DRILLING COMPANY

Rotary Drilling Contractors

1008 DOUGLAS BUILDING
104 S. BROADWAY
WICHITA, KANSAS 67202

April 2, 1979

15-145-20579-0000

Company;	Woodman & Iannitti Drilling Co.	
Farm;	Preston	Elevation 2016 K.B.
Location;	NE NW NW	
Section;	34-23-15W	
County;	Pawnee	
Contractor;	Woodman & Iannitti Drilling Co.	
Total Depth;	4200'	
Comm;	March 24, 1979	
Compl;	March 30, 1979	
Casing;	8 5/8 @ 346 w/250 sx.	
Production	D & A	

Figures Indicate Bottom Of Formations:

140	Sand
346	Shale
955	Redbed
978	Anhy
1981	Shale
2140	Shale & lime
2750	Shale & lime
3175	Lime
3418	Lime & shale
3840	Lime
4109	Lime
4200	Lime

I certify the above to be a true and correct copy of the drillers log to the best of my knowledge and belief.

Woodman & Iannitti Drilling Co.

K. T. Woodman
K. T. WOODMAN
CORPORATION COMMISSION

APR - 9 1979

CONSERVATION DIVISION
Wichita, Kansas