


15-45-30155-0000

STATE OF KANSAS
STATE CORPORATION COMMISSION

WELL PLUGGING RECORD

Give All Information Completely
Make Required Affidavit
Mail or Deliver Report to:
Conservation Division
State Corporation Commission
800 Bitting Building
Wichita, Kansas

Pawnee County, Sec. 23 Twp. 23 Rge. 15 (E) (W)

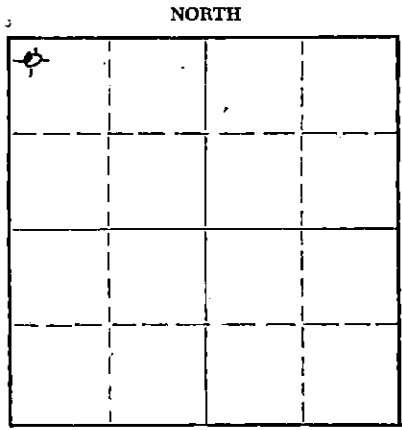

Location as "NE/CNW/SW" or footage from lines NW NW NW
Lease Owner Lee Phillips Oil Company etal
Lease Name Grizzell 'C' Well No. 1
Office Address Union Nat'l Bank Bldg., Wichita, Kansas
Character of Well (completed as Oil, Gas or Dry Hole) Dry Hole
Date well completed March 21, 1956 19
Application for plugging filed March 21, 1956 19
Application for plugging approved March 21, 1956 19
Plugging commenced March 21, 1956 19
Plugging completed March 21, 1956 19
Reason for abandonment of well or producing formation Dry Hole

Locate well correctly on above
Section Plat

If a producing well is abandoned, date of last production 19
Was permission obtained from the Conservation Division or its agents before plugging was commenced? Yes

Name of Conservation Agent who supervised plugging of this well R. M. Brundege
Producing formation _____ Depth to top _____ Bottom _____ Total Depth of Well 4123 Feet
Show depth and thickness of all water, oil and gas formations.

OIL, GAS OR WATER RECORDS

CASING RECORD

FORMATION	CONTENT	FROM	TO	SIZE	PUT IN	PULLED OUT
	Surface pipe	0	300'	8-5/8"	300'	None

Describe in detail the manner in which the well was plugged, indicating where the mud fluid was placed and the method or methods used in introducing it into the hole. If cement or other plugs were used, state the character of same and depth placed, from _____ feet to _____ feet for each plug set.

Filled hole with heavy mud to 300'.
Bridged hole at 300'. Ran 35 sacks
cement 300' up. Bridge hole at 40'
ran 15 sacks cement. Plug 40' to
base of cellar.


(If additional description is necessary, use BACK of this sheet)

Name of Plugging Contractor Isern Drilling Company
Address Box 45, Ellinwood, Kansas

STATE OF KANSAS COUNTY OF BARTON
I. M. M. Shropshire (employee of owner) or (owner/operator) of the above-described well, being first duly sworn on oath, says: That I have knowledge of the facts, statements, and matters herein contained and the log of the above-described well as filed and that the same are true and correct. So help me God.
(Signature) I. M. M. Shropshire
Lyons, Kansas (Address)

SUBSCRIBED AND SWORN TO before me this 22nd day of March, 1956
Sergeant Meyer Notary Public.

My commission expires Feb. 10, 1959.

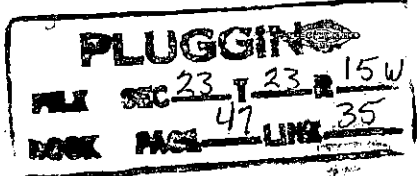

3-24-56

15-145-30155-0000

WELL LOG

LEE PHILLIPS OIL COMPANY ETAL, OWNER - GRIZZELL 'C' #1
NW/4 NW/4 NW/4 Section 23, Township 23, Range 15W,
Pawnee County, Kansas

ELEVATION: 1987 DF

Figures indicate bottom of formation
0 to 50 sand

PIPE RECORD:

Set 8-5/8" at 300'
Cemented with 250 sacks.
March 10, 1956

- 300 shale
- 355 Red Rock
- 440 sand
- 560 Red Rock
- 873 Red Bed
- 902 Anhydrite
- 1380 shale & shells
- 1530 salt
- 1800 shale & shells
- 2630 lime & shale
- 3020 shale & shells
- 3597 lime & shale
- 3700 lime
- 3930 lime & shale
- 3973 lime, shale & chert
- 4025 cherty conglomerate
- 4045 chert & lime
- 4123 lime & shale
- 4123 Rotary TD D&A

Rotary Commenced 3-10-56
Completed 3-21-56

STATE OF KANSAS)
COUNTY OF BARTON) SS

I, M. M. Shropshire, Drilling Superintendent of the above-described well, being first duly sworn on oath, declare: That I have knowledge of the facts, statements and matters herein contained pertaining to the log of the above-described well, as filed, and that the same are true and correct.

M. M. Shropshire

Subscribed and Sworn to before me this 22nd day of March, 1956.

George A Meyer

My commission expires Feb. 10, 1959.

PLUGGING

FILE SEC 23 T 23 R 15W

BOOK PAGE 47 LINE 35

RECORDED

STATE COMMISSION

MAR 24 1956

CONGRESSIONAL DIVISION

Wichita, Kansas