


15-145-30004-00-01

STATE OF KANSAS
STATE CORPORATION COMMISSION

Form CP-4

Give All Information Completely
Make Required Affidavit
Mail or Deliver Report to:
Conservation Division
State Corporation Commission
212 No. Market
Wichita, Kansas 67202

WELL PLUGGING RECORD

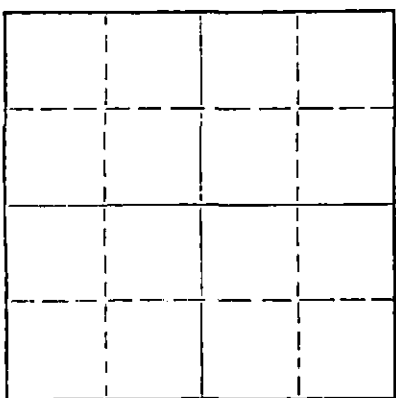

Locate well correctly on above
Section Plat

Pawnee County, Sec. 23 Twp. 23S Rge. 15 ~~23S~~ W (W)

Location as "NE/CNW/SW" or footage from lines 130' N of C SW SW SE

Lease Owner Oil Properties Co., Inc.

Lease Name Grizzell Well No. 1

Office Address 915 Century Plaza, Wichita, Kansas 67202

Character of Well (completed as Oil, Gas or Dry Hole) Dry Hole

Date well completed December 13, 19 71

Application for plugging filed December 13, 19 71

Application for plugging approved December 13, 19 71

Plugging commenced December 13, 19 71

Plugging completed December 13, 19 71

Reason for abandonment of well or producing formation No Productible Zone

If a producing well is abandoned, date of last production 19

Was permission obtained from the Conservation Division or its agents before plugging was commenced? Yes

Name of Conservation Agent who supervised plugging of this well Leo Massey

Producing formation _____ Depth to top _____ Bottom _____ Total Depth of Well 4138 Feet

Show depth and thickness of all water, oil and gas formations.

OIL, GAS OR WATER RECORDS

CASING RECORD

FORMATION	CONTENT	FROM	TO	SIZE	PUT IN	PULLED OUT
				8 5/8	221	0

Describe in detail the manner in which the well was plugged, indicating where the mud fluid was placed and the method or methods used in introducing it into the hole. If cement or other plugs were used, state the character of same and depth placed, from _____ feet to _____ feet for each plug set.

Put rubber plug in 8 5/8 and squeezed with 100 sacks cement, 6% calcium chloride.
Job complete at 9:45 PM 12-13-71.

RECEIVED
STATE CORPORATION COMMISSION
DEC 23 1971
CONSERVATION DIVISION
Wichita, Kansas

(If additional description is necessary, use BACK of this sheet)

Name of Plugging Contractor Garvey Drilling Company

Address Box 1164, Great Bend, Kansas 67530

STATE OF Kansas, COUNTY OF Barton, ss.
Ben E. Unruh (employee of owner) or ~~owner or operator~~ of the above-described

well, being first duly sworn on oath, says: That I have knowledge of the facts, statements, and matters herein contained and the log of the above-described well as filed and that the same are true and correct. So help me God.

(Signature) Ben E. Unruh

Box 1164, Great Bend, Kansas 67530
(Address)

SUBSCRIBED AND SWORN TO before me this 21st day of December, 19 71

James A. [Signature]
Notary Public.

My commission expires July 8, 1974

WELL LOG

15-145-30004-00-01

COMPANY **Oil Properties Co., Inc.**

SEC. **23** T. **23S** R. **15W**

FARM **Grizzell (OWNO) No. 1**

LOC. **130' N of C SW SW SE**


TOTAL DEPTH **4138**

COUNTY **Pawnee**

COMM. **12-10-71** COMP. **12-14-71**

CONTRACTOR **Garvey Drilling Company**

CASING
3 5/8" @ 221'

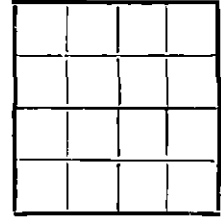

ELEVATION

PRODUCTION **D & A**

FIGURES INDICATE BOTTOM OF FORMATIONS

- 300' Cement (old plug's)
- 4110' Washdown old hole
- 4124' Simpson Shale
- 4134' Shale & Lime
- 4138' Arbuckle & Lima
- 4138' RTD

RECEIVED
STATE CORPORATION COMMISSION
DEC 23 1971
CONSERVATION DIVISION
Wichita, Kansas

State of Kansas }
County of Barton } SS

I, Charlene Markor of Garvey Drilling Company

upon oath state the above and foregoing is a true and correct copy of the log of the Grizzell (OWNO) No. 1 well.

Subscribed and sworn to before me this 21st day of December 19 71

My Commission Expires: July 8, 1974

Charlene Markor
Terrence A. Thomas
NOTARY PUBLIC