


WELL PLUGGING RECORD

Give All Information Completely
Make Required Affidavit
Mail or Deliver Report to:
Conservation Division
State Corporation Commission
212 North Market, Insurance Bldg.
Wichita, Kansas

Pawnee County. Sec. 23 Twp. 23 Rge. 15W (E) (W)
Location as "NE/CNW/SW" or footage from lines. SE1
Lease Owner Great Western Drilling Co.
Lease Name Grizzell Well No. # 1
Office Address Union Fidelity Building, Midland, Texas
Character of Well (completed as Oil, Gas or Dry Hole) _____
Date well completed _____ 19____
Application for plugging filed yes 19____
Application for plugging approved yes 19____
Plugging commenced 5-3-60 19____
Plugging completed 5-13-60 19____
Reason for abandonment of well or producing formation _____

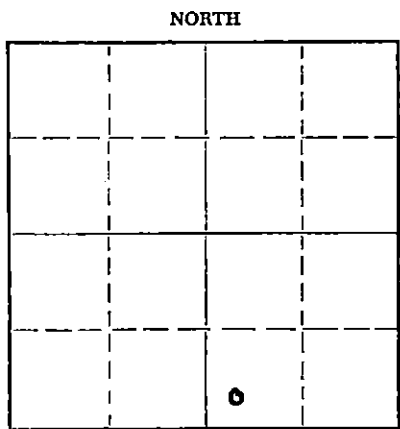

Locate well correctly on above Section Plat

If a producing well is abandoned, date of last production _____ 19____
Was permission obtained from the Conservation Division or its agents before plugging was commenced? yes

Name of Conservation Agent who supervised plugging of this well Frank Broadfoot
Producing formation _____ Depth to top _____ Bottom _____ Total Depth of Well 1,150' Feet
Show depth and thickness of all water, oil and gas formations.

OIL, GAS OR WATER RECORDS

CASING RECORD

FORMATION	CONTENT	FROM	TO	SIZE	PUT IN	PULLED OUT
				5 1/2"		2,639'

Describe in detail the manner in which the well was plugged, indicating where the mud fluid was placed and the method or methods used in introducing it into the hole. If cement or other plugs were used, state the character of same and depth placed, from _____ feet to _____ feet for each plug set.

Plugging commenced 5-3-60. Plugging completed 5-13-60. Measured into total depth, 1,150'. Plugged off bottom with sand (20') and dumped 3 sacks of cement. Well leaked some gas, so dumped 20 buckets of sand on cement. Worked and shot casing. Spotted 76 barrels of oil. Shot 5 1/2" casing free at 2,639'. Pulled and laid down casing. Pumped in 14 barrels of mud with plug (190') and squeezed the well with 60 sacks of cement.

RECEIVED
STATE CORPORATION COMMISSION

MAY 23 1960

CONSERVATION DIVISION
Wichita, Kansas

(If additional description is necessary, use BACK of this sheet)

Name of Plugging Contractor J. O. Forbes d/h/a Forbes Casing Pulling Co.
Address Box 221 Great Bend, Kansas

STATE OF Kansas, COUNTY OF Barton, ss.
J. O. Forbes (employee of owner) or (owner or operator) of the above-described well, being first duly sworn on oath, says: That I have knowledge of the facts, statements, and matters herein contained and the log of the above-described well as filed and that the same are true and correct. So help me God.

(Signature) J. O. Forbes
J. O. Forbes
Box 221 Great Bend, Kansas
(Address)

SUBSCRIBED AND SWORN to before me this 16th, day of May, 19 60

My commission expires December 8th, 1963

Kayann Jenkins
Kayann Jenkins
Notary Public.



WELL LOG BUREAU—KANSAS GEOLOGICAL SOCIETY
508 East Murdock, Wichita, Kansas


15-145-00380-0000
COPY

Company. LOFFLAND BROTHERS CO.
Farm. Grizzell No. 1

SEC. 23 T. 23 R. 15W
SW SW SE

Total Depth. 4150
Comm. 12-8-54 Comp. 2-18-55
Shot or Treated.
Contractor.
Issued. 1-7-56

County Pawnee
KANSAS

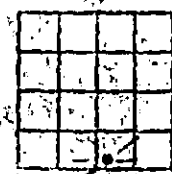

CASING:
8 5/8 230'
5 1/2 4148'

Elevation. 2012 RB

Production. 1,634,000 CFGPD

Figures indicate Bottom of Formations.

shale & sand	400
red bed & shale	925
anhydrite & shale	1270
shale & red bed	1490
salt & shale	1820
broken lime & shale	1974
broken lime	2100
broken lime & shale	2170
lime	2264
lime & shale	2424
broken lime	2559
lime & shale	2905
broken lime	3070
lime & shale	3646
lime	3965
conglomerate	3993
cherty lime	3015
chert & shale	4074
shale & sand	4145
lime	4150
Total Depth	

RECEIVED
STATE CORPORATION COMMISSION
APR 15 1960
CONSERVATION DIVISION
Wichita, Kansas

SCOUT TOPS:	
Anhydrite	922
Heebner	3475
Toronto	3497
Douglas	3515
Iatan	3615
Lansing	3624
Base K. C.	3862
Conglomerate	3951
Viola	3990
Simpson shale	4058
Simpson sand	4082
Arbuckle	4134