


15-145-21009-0000

WELL PLUGGING RECORD

Give All Information Completely
 Make Required Affidavit

COUNTY Pawnee SEC. 24 TWP. 23S RGE. 15W ~~EW~~
 Location as in quarters or footage from lines:
50'S of SE SW SE 50'E

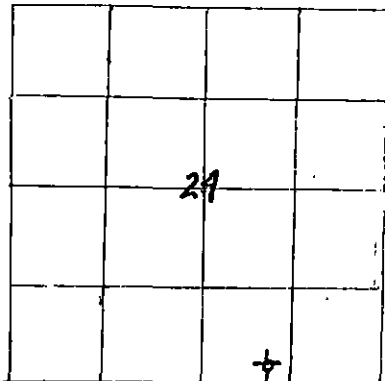

Locate Well
 correctly on above
 Section Platt.

Lease Owner Alpine Drilling Co., Inc.
 Lease Name Murphy Well No. 1
 Office Address 200 E. First, Suite 500, Wichita, KS 67202
 Character of Well (Completed as Oil, Gas or Dry Hole): Dry Hole
 Date Well Completed January 1, 1983
 Application for plugging filed January 1, 1983
 Plugging commenced January 1, 1983
 Plugging completed January 1, 1983
 Reason for abandonment of well or producing formation _____

Was permission obtained from the Conservation Division or it's
 Agent's before plugging was commenced? yes

Name of Conservation Agent who supervised plugging of this well Bud Mitz
 Producing formation _____ Depth to top _____ bottom _____ T.D. 4158
 Show depth and thickness of all water, oil and gas formations.

OIL, GAS OR WATER RECORDS

Casing Record

Formation	Content	From	To	Size	Put in	Pulled Out
Surface	shale	0	384	8-5/8	380	none
	cemented with 275 sx common, 2% gel, 3% cc plug down at 2:30 p.m. by Allied; cement did circ.					

Describe in detail the manner in which the well was plugged, indicating where the mud
 fluid was placed and the method or methods used in introducing it into the hold. If cement
 or other plugs were used, state the character of same and depth placed, from _____ feet
 to _____ feet for each plug set.

Plugged as follows with 50/50 poz, 4% gel, 3% cc
70 sx @ 920'; 40 sx @ 370'; 10 sx @ 40'; 10 sx in rathole; 5 sx in water
well w/solid bridge plug at 40'; job completed at 5 p.m. 1-1-83
By Allied


(If additional description is necessary, use BACK of this sheet)

Name of Plugging Contractor J. W. Drilling Co., Inc.

STATE OF KANSAS COUNTY OF SEDGWICK, ss.
Jon T. Williams, Jr. (employee of owner) or (owner or operator) of the
 above-described well, being first duly sworn on oath, says: That I have knowledge of the
 facts, statements, and matters herein contained and the log of the above-described well as
 filed and that the same are true and correct. So help me God.

(Signature) [Signature]
200 E. First, Suite 500, Wichita, KS
 (Address) _____ 67202

Subscribed and sworn to before me this 1st day of January, 1983

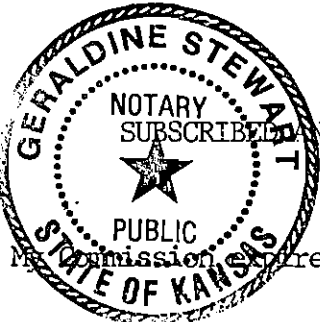

Geraldine Stewart
 Geraldine Stewart, Notary Public.

My Commission Expires: January 14, 1985

JAN 10 1983

Wichita, Kansas