


WELL PLUGGING RECORD 15-145-00509-0000

NORTH

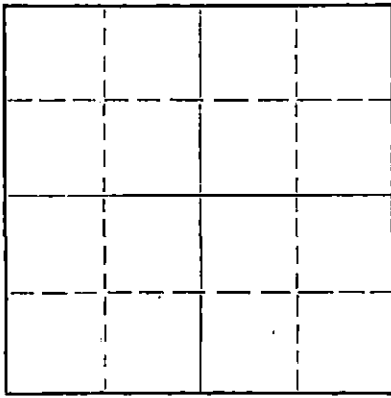

Locate well correctly on above  
 Section Plat

Pawnee County, Sec. 24 Twp. 23 Rge. 15 (W) (W)  
 Location as "NE/CNW/SW" or footage from lines SW NW NE  
 Lease Owner Leben Drilling, Inc.  
 Lease Name Hazel Johnson Well No. 1  
 Office Address P. O. Box 486, Great Bend, Kansas  
 Character of Well (completed as Oil, Gas or Dry Hole) Dry Hole  
 Date well completed 4-11-64 19  
 Application for plugging filed 4-11-64 19  
 Application for plugging approved 4-11-64 19  
 Plugging commenced 4-11-64 19  
 Plugging completed 4-11-64 19  
 Reason for abandonment of well or producing formation Dry Hole

If a producing well is abandoned, date of last production \_\_\_\_\_ 19\_\_\_\_  
 Was permission obtained from the Conservation Division or its agents before plugging was commenced? yes

Name of Conservation Agent who supervised plugging of this well Eldon Petty, Hays, Kansas  
 Producing formation \_\_\_\_\_ Depth to top \_\_\_\_\_ Bottom \_\_\_\_\_ Total Depth of Well 4040 Feet  
 Show depth and thickness of all water, oil and gas formations.

OIL, GAS OR WATER RECORDS

CASING RECORD

FORMATION	CONTENT	FROM	TO	SIZE	PUT IN	PULLED OUT
				8 5/8"	283'	none

Describe in detail the manner in which the well was plugged, indicating where the mud fluid was placed and the method or methods used in introducing it into the hole. If cement or other plugs were used, state the character of same and depth placed, from \_\_\_\_\_ feet to \_\_\_\_\_ feet for each plug set.

Filled hole with Mud & put 100 sacks cement in pipe with swedge

**RECEIVED**  
 STATE CORPORATION COMMISSION

APR 14 1964

CONSERVATION DIVISION  
 Wichita, Kansas

(If additional description is necessary, use BACK of this sheet)

Name of Plugging Contractor Leben Drilling, Inc.  
 Address P. O. Box 486, Great Bend, Kansas

STATE OF KANSAS, COUNTY OF BARTON, ss.

Leslie Kite (employee of owner) or (owner or operator) of the above-described well, being first duly sworn on oath, says: That I have knowledge of the facts, statements, and matters herein contained and the log of the above-described well as filed and that the same are true and correct. So help me God.

(Signature)

*Leslie Kite*

P. O. Box 486, Great Bend, Kansas  
 (Address)

SUBSCRIBED AND SWORN TO before me this 13th day of April, 19 64.

My commission expires April 1, 1967

*Ulanda Nichols*  
 Ulanda Nichols Notary Public.

DRILLER'S LOG

15-145-00509-0000

COMPANY: Leben Drilling, Inc.  
 CONTRACTOR: LEBEN DRILLING, INC.  
 FARM: HAZEL JOHNSON #1  
 LOCATION: SW NW NE Sec. 24-23-15  
 PAWNEE COUNTY, KANSAS  
 COMMENCED: 4-3-64  
 COMPLETED: 4-11-64

0	35	Clay
35	95	Sand & Clay
95	185	Sand
185	284	Shale
284	325	Shale & Clay
325	375	Sand & Shale
375	650	Redbed & Shale
650	885	Shale & Shells
885	905	Anhydrite
905	1905	Shale & Shells
1905	2605	Shale & Lime
2605	3155	Lime & Shale
3155	3440	Shale & Lime
3440	3580	Lime & Shale
3580	3735	Shale & Lime
3735	3805	Lime & Shale
3805	3945	Shale & Lime
3945	3990	Lime
3990	3995	Lime & Chert
3995	4040	Lime & Chert
	<u>4040</u>	<u>Rotary Total Depth - D. &amp; A.</u>

RECEIVED  
 STATE CORPORATION COMMISSION  
 APR 14 1964  
 CONSERVATION DIVISION  
 Wichita, Kansas

Set 8 5/8" used surface casing @ 283' with 265 sacks Sunset.

I, Leslie Kite, do hereby certify that the above and foregoing is a true and correct copy of the log of the Hazel Johnson #1 well, located SW NW NE of Section 24, Township 23, Range 15, Pawnee County, Kansas, as reflected by the files of Leben Drilling, Inc.

*Leslie Kite*

Leslie Kite

STATE OF KANSAS )  
 ) SS  
 COUNTY OF BARTON )

Subscribed and sworn to before me, a Notary Public, in and for Barton County, Kansas, this 13th day of April, 1964.

*Ulanda Nichols*

Ulanda Nichols, Notary Public

My Commission Expires:  
 April 1, 1967