

15-45-30088-0000

STATE OF KANSAS
STATE CORPORATION COMMISSION

Form CP-4

Give All Information Completely
Make Required Affidavit
Mail or Deliver Report to:
Conservation Division
State Corporation Commission
211 No. Broadway
Wichita, Kansas

WELL PLUGGING RECORD

Pawnee County. Sec. 25 Twp. 23S Rge. 15W (~~EX~~) (W)

Location as "NE/CNW/SW" or footage from lines NE SW NE

Lease Owner D. R. Lauck Oil Company, Inc.

Lease Name Guyer "B" Well No. 1

Office Address 301 S. Broadway, Wichita, Kansas

Character of Well (completed as Oil, Gas or Dry Hole) Dry Hole

Date well completed December 17, 19 65

Application for plugging filed December 17, 19 65

Application for plugging approved December 17, 19 65


Plugging commenced December 17, 19 65

Plugging completed December 17, 19 65

Reason for abandonment of well or producing formation Dry Hole

If a producing well is abandoned, date of last production _____ 19 _____

Was permission obtained from the Conservation Division or its agents before plugging was commenced? Yes

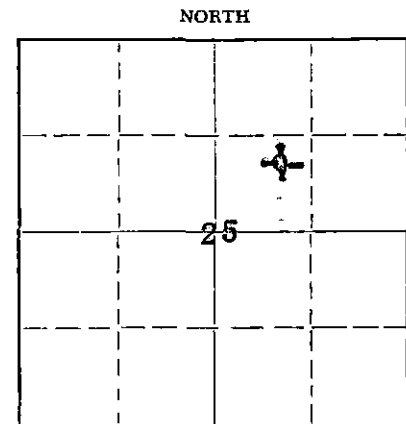

Locate well correctly on above Section Plat

Name of Conservation Agent who supervised plugging of this well Gilbert Leiker

Producing formation _____ Depth to top _____ Bottom _____ Total Depth of Well 4005 Feet

Show depth and thickness of all water, oil and gas formations.

OIL, GAS OR WATER RECORDS

CASING RECORD

FORMATION	CONTENT	FROM	TO	SIZE	PUT IN	PULLED OUT
		0'	222'	8-5/8"	222'	None

Describe in detail the manner in which the well was plugged, indicating where the mud fluid was placed and the method or methods used in introducing it into the hole. If cement or other plugs were used, state the character of same and depth placed, from _____ feet to _____ feet for each plug set.

4005' - 200' Mud
 200' - 196' Plug
 196' - 40' Cement, 25 sacks
 40' - 36' Plug
 36' - 6' Cement, 10 sacks & 1/2 sack hulls.
 (Bottom of cellar)

RECEIVED
STATE CORPORATION COMMISSION

DEC 28 1965

CONSERVATION DIVISION
Wichita, Kansas

Name of Plugging Contractor Lauck Drilling Company, Incorporated
Address 301 S. Broadway, Wichita, Kansas

STATE OF KANSAS COUNTY OF SEDGWICK, ss.
John H. Knightley (employee of owner) or (owner or operator) of the above-described

well, being first duly sworn on oath, says: That I have knowledge of the facts, statements, and matters herein contained and the log of the above-described well as filed and that the same are true and correct. So help me God.

(Signature) John H. Knightley
301 S. Broadway, Wichita, Kansas
(Address)

SUBSCRIBED AND SWORN TO before me this 27th day of December, 19 65

My commission expires March 12, 1967
Stella J. Lopez Notary Public.

D. R. Lauck Oil Company, Inc.

Guyer "B" #1

NE SW NE Sec. 25-23S-15W
Pawnee County, Kansas

15-145-30088-0000

Commenced: December 9, 1965
Completed: December 17, 1965

Casing Record: 222' 8-5/8" Cemented with 180 sacks Cement,
4 sacks Calcium Chloride.

Elevation: GL 1985; DF 1988; KB 1990.

Drillers Log

Tops

Sand	170
Shale	390
Sale	445
Red Bed, Shale	912
Anhydrite	940
Shale & Shell	1545
Shale	1895
Lime & Shale	2343
Shale & Lime	2475
Lime & Shale	2665
Shale & Lime	3316
Broken Lime	3510
Shale & Lime	3652
Lime & Shale	3725
Lime	3855
Lime & Shale	3937
Shale & Lime	4000
Chert	4005 RTD

	Samples
Anhydrite (driller)	912+1078
Heebner	3475-1485
Douglas	3517-1527
Brown Lime	3616-1626
Lansing	3627-1637
Base Kansas City	3884-1894
Viola	3980-1990
Total Depth	4005-2015

DST #1 (M) 3812-30, open 1 hour with weak blow to fair blow 1 hour. Recovered 350' fluid: 60' thin mud with slight show of oil, 290' water. ISIP 850#, 30 min. FSIP 805#, 30 min. IFP 40#. FFP 170#.

DST #2 (M) 3965-4005, open 1 hour with fair decreasing to weak blow at end of hour. Flushed tool. Recovered 60' thin watery mud. ISIP 94#, 30 min. FSIP 91#, 30 min. IFP 67#. FFP 78#.

D&A

RECEIVED
STATE CORPORATION COMMISSION

DEC 28 1965

CONSERVATION DIVISION
Wichita, Kansas

Certified by:

John H. Knightley
John H. Knightley, Secretary