


15-145-26443-0000

STATE OF KANSAS
STATE CORPORATION COMMISSION
CONSERVATION DIVISION
P. O. BOX 17027
WICHITA, KANSAS 67217

FORM CP-4

WELL PLUGGING RECORD

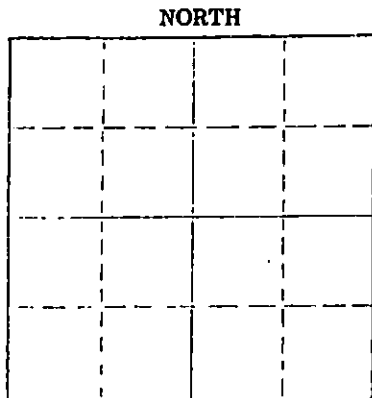

Locate well correctly on above Section Plot

Pawnee County. Sec. 25 Twp. 23S Rge. 15W (W)
Location as "NE/CNW&SW" or footage from lines SW SW SW
Lease Owner Alpine Drilling Company
Lease Name English #1 Well No. 1
Office Address 800 Bitting Building, Wichita, Kansas 67202
Character of Well (completed as Oil, Gas or Dry Hole) Dry Hole
Date well completed January 1, 1977 19
Application for plugging filed December 31, 1976 19
Application for plugging approved December 31, 1976 19
Plugging commenced 7:00 AM, January 1, 1977 19
Plugging completed 8:15 AM, January 1, 1977 19
Reason for abandonment of well or producing formation Dry Hole

If a producing well is abandoned, date of last production _____ 19
Was permission obtained from the Conservation Division or its agents before plugging was commenced? Yes

Name of Conservation Agent who supervised plugging of this well Leo Massey
Producing formation _____ Depth to top _____ Bottom _____ Total Depth of Well 4161' feet
Show depth and thickness of all water, oil and gas formations.

OIL, GAS OR WATER RECORDS

CASING RECORD

FORMATION	CONTENT	FROM	TO	SIZE	PUT IN	PULLED OUT
				8 5/8"	387'	None

Describe in detail the manner in which the well was plugged, indicating where the mud fluid was placed and the method or methods used in introducing it into the hole. If cement or other plugs were used, state the character of same and depth placed, from _____ feet to _____ feet for each plug set.

Filled hole with heavy mud.
Pumped 10 sacks of ~~50~~ 50/50 Pozmix with
2% gel thru open end of drillpipe at 360',
mud to 40', 1/2 sack hulls and wood plug,
solid bridge, 10 sacks to base of collar.

(If additional description is necessary, use BACK of this sheet)

Name of Plugging Contractor STERLING DRILLING COMPANY
Address P. O. Box 129, Sterling, Kansas 67579

STATE OF KANSAS COUNTY OF RICE
F. A. Wuellner (employee of owner) or (owner or operator) of the above-described

well, being first duly sworn on oath, says: That I have knowledge of the facts, statements, and matters herein contained and the log of the above-described well as filed and that the same are true and correct. So help me God. STERLING DRILLING COMPANY

(Signature) [Signature]
F. A. Wuellner, Secretary
P. O. Box 129, Sterling, Kansas 67579
(Address)

Subscribed and sworn to before me this 4th day of January, 19 77

CHARLES HALL—NOTARY PUBLIC
My Commission Expires _____

[Signature]
Charles M. Hall, Notary Public.



STERLING DRILLING COMPANY
P. O. Box 129
Sterling, Kansas 67579

15-145-20443.0000

WELL LOG ----- ENGLISH #1
Located: SW SWSW, Section 25-23S-15W, Pawnee County, Kansas

OWNER: Alpine Drilling Company
ROTARY DRILLING CONTRACTOR: Sterling Drilling Company

COMMENCED: December 18, 1976
COMPLETED: January 1, 1977

TOTAL DEPTH: 4161'

LOG	
0 - 140	Sand and Clay
140 - 390	Shale
390 - 938	Sand and shale
938 - 959	Anhydrite
959 - 1120	Shale and shells
1120 - 1860	Shale
1860 - 2960	Shale and Lime
2960 - 3150	Lime
3150 - 3685	Lime and Shale
3685 - 3900	Lime
3900 - 4035	Lime and Shale
4035 - 4080	Lime, Shale and Chert
4080 - 4126	Chert and Shale, Sand
4126 - 4161	Lime and Shale

CASING RECORD:

Ran 9 joints used 8 5/8" casing, 375.91'
set at 387' K.B. with 275 sacks Common
with 2% gel and 3 1/2 cc. Plug down at
10:30 PM, 12-18-76 by Allied.

RECEIVED
STATE CORPORATION COMMISSION

JAN 06 1977

CONSERVATION DIVISION
Wichita, Kansas

Plugged.