

15145-61061-0000

STATE OF KANSAS
STATE CORPORATION COMMISSION


WELL PLUGGING RECORD

Give All Information Completely
Make Required Affidavit
Mail or Deliver Report to:
Conservation Division
State Corporation Commission
800 Bittling Building
Wichita, Kansas

Pawnee County, Sec. 30 Twp. 23 Rge. (E) 15 (W)

Location as "NE/CNW/SW" or footage from lines NE SW SW/4
Lease Owner M. B. Armer
Lease Name Garvin Well No. 4
Office Address 710 Petroleum Bldg., Wichita 2, Kans.
Character of Well (completed as Oil, Gas or Dry Hole) dry
Date well completed Jan. 2, 1953
Application for plugging filed Jan. 2, 1953
Application for plugging approved Jan. 2, 1953
Plugging commenced Jan. 2, 1953
Plugging completed Jan. 2, 1953
Reason for abandonment of well or producing formation Dry

NORTH

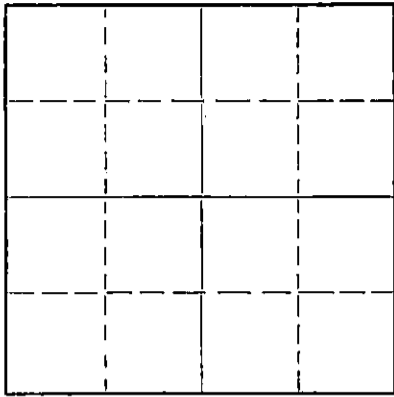

Locate well correctly on above
Section Plat

If a producing well is abandoned, date of last production 19
Was permission obtained from the Conservation Division or its agents before plugging was commenced? Yes

Name of Conservation Agent who supervised plugging of this well M. A. Rives
Producing formation Depth to top Bottom Total Depth of Well 4105 Feet
Show depth and thickness of all water, oil and gas formations.

OIL, GAS OR WATER RECORDS

CASING RECORD

FORMATION	CONTENT	FROM	TO	SIZE	PUT IN	PULLED OUT
				8 5/8"	296'	None

Describe in detail the manner in which the well was plugged, indicating where the mud fluid was placed and the method or methods used in introducing it into the hole. If cement or other plugs were used, state the character of same and depth placed, from feet to feet for each plug set.

Filled hole with heavy Rotary mud to 270 ft.
set plug and ran 20 sacks cement through
drill pipe. Mudded hole to 35 ft., set plug
and 10 sacks cement at the surface.

(If additional description is necessary, use BACK of this sheet)

Name of Plugging Contractor M. B. Armer
Address 710 Petroleum Bldg., Wichita 2, Kans.


STATE OF Kansas, COUNTY OF Sedgwick, ss.
L. C. Sponenberg (employee of owner) or (owner/contractor) of the above-described well, being first duly sworn on oath, says: That I have knowledge of the facts, statements, and matters herein contained and the log of the above-described well as filed and that the same are true and correct. So help me God.

(Signature) L. C. Sponenberg
(Address)

SUBSCRIBED AND SWORN TO before me this 11th day of January, 1953

Lorraine M. Johnson
Notary Public.

My commission expires Oct. 13, 1956

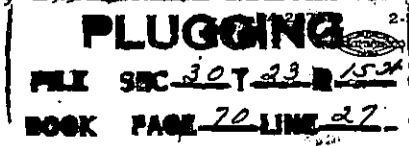

1-16-53

15-145-01061-0000

LOG

Company: M. B. Armer
Contractor: M. B. Armer (Ideco Rig)
Drilling Commenced: 12/18/52
Drilling Completed: 1/3/53
Elevation: 2049 D.F.
2052 K.B.

Farm: Garvin #4
Location: NE SW SW
Sec. 30-239-15W
Pawnee County, Kans.
Casing Record: 8-5/8" casing at
296' with 175 sacks

(figures below indicate bottoms)

Sand & Surface Clay	125	
Shale	306	
Red Bed & Shale	850	
Anhydrite	880	
Red Bed, Shale & Shells	920	
Shale & Red Bed	1188	
Shale, Red Bed & Salt	1600	
Shale & Shells & Sand	1800	
Lime & Shale	2125	
Lime (Broken)	2250	
Lime & Shale	2395	
Lime	2485	
Lime & Shale	2785	
Shale, Lime & Shells	2935	
Shale & Shells	3045	
Shale, Shells & Lime	3160	
Shale & Shells	3260	
Lime & Shale	3655	
Lime	4005	
Shale & Lime	4056	
Chert & Shale	4065	
Shale	4085	
Lime	4105	
R.T.D.	4105	T.D. - D&A

FORMATION TOPS (R.B. Meas.)

Heebner	3492
Lansing-Kansas City	3633
Viola	4019
Simpson	4054
Arbuckle	4085

I hereby certify that this is a true and correct log of the above described well as shown by the drilling reports.

M. B. ARMER

By *L. P. Johnson*

STATE OF KANSAS
COUNTY OF SEDGWICK

Subscribed and sworn to before me, a notary public, in and for said County and State this 15th day of January, 1953.

Lorraine M. Johnson
Notary Public

My Commission Expires: Oct. 13, 1956.

PLUGGING
FILE SEC 30-239-15W
BOOK PAGE 70 LINE 27