


Give All Information Completely
Make Required Affidavit
Mail or Deliver Report to:
Conservation Division
State Corporation Commission
211 N. Broadway
Wichita, Kansas

WELL PLUGGING RECORD

15-145-01329-0000

R

NORTH

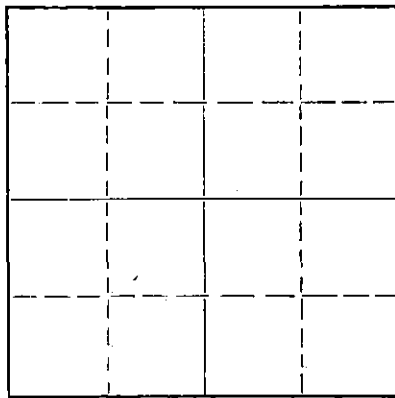

Locate well correctly on above
Section Plat

Pawnee County, Sec. 30 Twp. 23 Rge. (E) 15(W)

Location as "NE/CNW/SW" or footage from lines CN/2 SE SE

Lease Owner Quality Supply Co.

Lease Name Hall "B" Well No. 2

Office Address 202 Petroleum Bldg., Wichita, Kansas

Character of Well (completed as Oil, Gas or Dry Hole) Oil

Date well completed 19

Application for plugging filed 19

Application for plugging approved 19

Plugging commenced 11-11-60 19

Plugging completed 11-14-60 19

Reason for abandonment of well or producing formation

If a producing well is abandoned, date of last production 19

Was permission obtained from the Conservation Division or its agents before plugging was commenced? yes

Name of Conservation Agent who supervised plugging of this well Frank Broadfoot

Producing formation Depth to top Bottom Total Depth of Well 4091 Feet

Show depth and thickness of all water, oil and gas formations.

OIL, GAS OR WATER RECORDS

CASING RECORD

FORMATION	CONTENT	FROM	TO	SIZE	PUT IN	PULLED OUT
				8 5/8"	297	none
				5 1/2"	4067	3092'

Describe in detail the manner in which the well was plugged, indicating where the mud fluid was placed and the method or methods used in introducing it into the hole. If cement or other plugs were used, state the character of same and depth placed, from feet to feet for each plug set.

Sanded hole to 4055'-dumped 5 sks cement-
mudded hole to 250'-set 10' rock bridge-
dumped 20 sks cement-mudded hole to 40'-
set 10' rock bridge-dumped 10 sks cement.

PERMITTED
STANDARD PERMISSION

DEC 8 1960

CONSERVATION DIVISION
Wichita, Kansas

12-8-60

Name of Plugging Contractor R & D Casing Pulling Co. License #236
Address Box 154, Ellinwood, Kansas

STATE OF Kansas, COUNTY OF Sedgwick, ss.
Jack Shear (employee of owner) or (owner or operator) of the above-described

well, being first duly sworn on oath, says: That I have knowledge of the facts, statements, and matters herein contained and the log of the above-described well as filed and that the same are true and correct. So help me God.

(Signature) Jack Shear President
202 Pet. Bldg.
(Address)

SUBSCRIBED AND SWORN to before me this 29th day of November, 1960

My commission expires June 1, 1963
Lee Mankin Notary Public.



WELL LOG BUREAU—KANSAS GEOLOGICAL SOCIETY
508 East Mufdock, Wichita, Kansas


COPY
15-145-01329-0000

Company- M. B. ARMER
Farm- Hall "B" No. 2

SEC. 30 T. 23 R. 15W
C N/2 SE SE

Total Depth. 4091
Comm. 12-15-54 Comp. 12-31-54
Shot or Treated.
Contractor. Armco, Inc.
Issued. 4-30-55

County Pawnee KANSAS

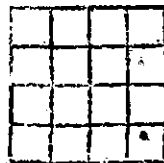

CASING:

8" 297'
5" 4067'

Elevation. 2050 KB

Production. 204 BO

Figures indicate Bottom of Formations

sand	150
shale & shells	460
sand	510
shale & shells	900
shaley redbed & shale	958
Anhydrite	995
shale, shells, salt & redbed	1220
shale & shells	1595
shale & lime	3705
lime	3764
lime & shale	3790
lime	3875
lime & shale	3980
lime, shale & chert	4030
lime, shale & sand	4035
lime	4091
Total depth	

Tops: (Meas. K.B.)	
Hochner	3486
Brown lime	3616
Lansing	3625
Viola	3998
Simpson shale	4028
Simpson sand	4045
Arbuckle	4066

RECEIVED
STATE GEOLOGICAL COMMISSION

DEC 8 1960

CONSERVATION DIVISION
Wichita, Kansas

Sand to 4055' dump 5 S.T.