

15-145-06/94-0000

STATE OF KANSAS
STATE CORPORATION COMMISSION


Give All Information Completely
Make Required Affidavit
Mail or Deliver Report to:
Conservation Division
State Corporation Commission
211 No. Broadway
Wichita, Kansas

WELL PLUGGING RECORD

Pawnee County, Sec. 30 Twp. 23 Rge. (E) 15 (W)

Location as "NE/CNW/SW" or footage from lines SW SE SE
Lease Owner: Quality Supply Co.
Lease Name: Hall "B" Well No. 1
Office Address: 202 Petroleum Bldg., Wichita, Kansas
Character of Well (completed as Oil, Gas or Dry Hole): Oil
Date well completed: 19
Application for plugging filed: 19
Application for plugging approved: 19
Plugging commenced: 11-15-60 19
Plugging completed: 11-18-60 19
Reason for abandonment of well or producing formation:

NORTH

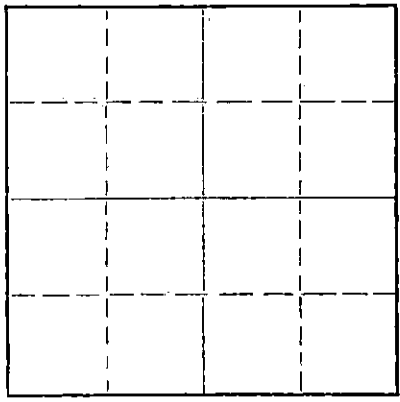

Locate well correctly on above
Section Plat

If a producing well is abandoned, date of last production: 19
Was permission obtained from the Conservation Division or its agents before plugging was commenced? yes

Name of Conservation Agent who supervised plugging of this well: Frank Broadfoot
Producing formation: Depth to top: Bottom: Total Depth of Well: 4071 Feet
Show depth and thickness of all water, oil and gas formations.

OIL, GAS OR WATER RECORDS

CASING RECORD

FORMATION	CONTENT	FROM	TO	SIZE	PUT IN	PULLED OUT
				8 5/8"	282'	none
				5 1/2"	3950' 4070'	2950'

Describe in detail the manner in which the well was plugged, indicating where the mud fluid was placed and the method or methods used in introducing it into the hole. If cement or other plugs were used, state the character of same and depth placed, from feet to feet for each plug set.

Sanded hole to 4060'-dumped 5 sks cement-
Mudded to 250'-set 10' rock bridge-dumped
20 sks cement-mudded to 40'-set 10' rock
bridge-dumped 10 sks cement.

DEC 8 1960
CONSERVATION DIVISION
Wichita, Kansas

(If additional description is necessary, use BACK of this sheet)
Name of Plugging Contractor: R & D Casing Pulling Co. License #236
Address: Box 154, Ellinwood, Kansas

STATE OF Kansas, COUNTY OF Sedgwick, ss.
Jack Shear (employee of owner) or (owner or operator) of the above-described well, being first duly sworn on oath, says: That I have knowledge of the facts, statements, and matters herein contained and the log of the above-described well as filed and that the same are true and correct. So help me God.

(Signature) Jack Shear
202 Petroleum Building, Wichita 2, Kansas
(Address)

SUBSCRIBED AND SWORN TO before me this 7th day of December, 1960

My commission expires June 1, 1963
Lee Mankin Notary Public.




WELL LOG BUREAU—KANSAS GEOLOGICAL SOCIETY
508 East Murdock, Wichita, Kansas

COPY
15-145-00199-0000

Company- M. B. ARMER
Farm- Hall "B" No. 1

SEC. 30 T. 23 R. 15W
SW SE SE

Total Depth: 4071
Comm: 7-2-54 Comp. 7-15-54
Shot or Treatment:
Contractor: Armer, Inc.
Issued: 9-25-54

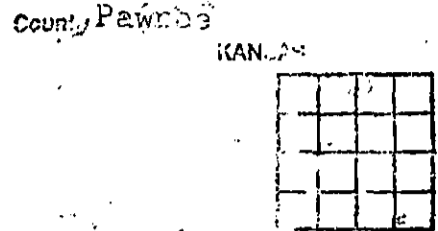

CASING:
8 5/8 282'
5 1/2 4070'

Elevation: 2063 KP
Production: BH5 1298 BO, no W

Figures Indicate Bottom of Formations.

sand & clay	190
shale	282
shale & shells	455
sand	525
red bed & shale	968
anhydrite	990
shale & shells	1725
shale & lime	1950
lime	2095
shale & lime	2370
lime	2430
shale & lime	3732
lime	3765
shale & lime	3839
lime	3915
shale & lime	4058
lime	4071
Total Depth	

TOPS: (KB Meas.)	
Heebner	3494
Brown lime	3620
Lansing KC	3630
Base KC	3855
Viola	4003
Arbuckle	4060

4070
1200

2870

RECEIVED
STATE COMMISSION
DEC 8 1954
CONSERVATION DIVISION
Wichita, Kansas