

STATE OF KANSAS  
STATE CORPORATION COMMISSION

WELL PLUGGING RECORD

Give All Information Completely  
Make Required Affidavit  
Mail or Deliver Report to:  
Conservation Division  
State Corporation Commission  
500 Bittling Building  
Wichita, Kansas

OR

FORMATION PLUGGING RECORD

Strike out upper line  
when reporting plugging  
off formations.

Stafford County. Sec. 11 Twp. 21S Rge. (E) 24 (W)

Location as "NE $\frac{1}{4}$ NW $\frac{1}{4}$ SW $\frac{1}{4}$ " or footage from lines. SB 02 NE

Lease Owner. W. L. Hartman, et al

Lease Name. Ansahite Well No. 1

Office Address. P. O. Box 51, Wichita 1, Kansas

Character of Well (completed as Oil, Gas or Dry Hole) dry hole

Date well completed. 11-29-15 19

Application for plugging filed. 11-29-15 19

Application for plugging approved. 11-29-15 19


Plugging commenced. 11-29-15 19

Plugging completed. 11-29-15 19

Reason for abandonment of well or producing formation dry hole

If a producing well is abandoned, date of last production: --- 19

Was permission obtained from the Conservation Division or its agents before plugging was commenced? yes

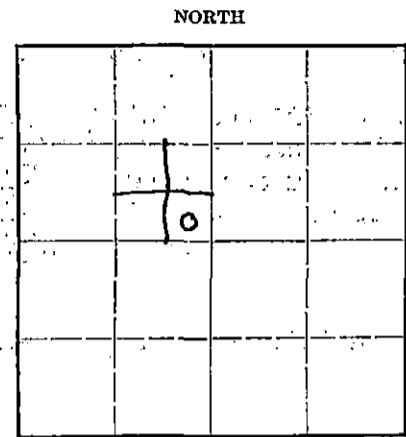

Locate well correctly on above  
Section Flat

Name of Conservation Agent who supervised plugging of this well. H. F. Kartz

Producing formation. none Depth to top. --- Bottom. --- Total Depth of Well. 3750 Feet

Show depth and thickness of all water, oil and gas formations.

OIL, GAS OR WATER RECORDS

CASING RECORD

Formation	Content	From	To	Size	Put In	Pulled Out
surface pipe	358	0'	358'	8 5/8"	358	none

Describe in detail the manner in which the well was plugged, indicating where the mud fluid was placed and the method or methods used in introducing it into the hold. If cement or other plugs were used, state the character of same and depth placed, from \_\_\_\_\_ feet to \_\_\_\_\_ feet for each plug set.

Hole was filled with heavy mud from bottom to 358', set bridge and cemented with 15 sacks. Hole was filled with heavy mud to 15 feet, set bridge, surface pipe was cut off at base of collar, cemented with 10 sacks, cement returning to base of collar and covering surface pipe at point where it had been cut.

12-7-45



11 21 1460  
35 27

(If additional description is necessary, use BACK of this sheet)

Correspondence regarding this well should be addressed to W. L. Hartman  
Address P. O. Box 51, Wichita 1, Kansas.

STATE OF Kansas, COUNTY OF Barton, ss.  
I. O. W. Keyes, drilling contractor (employee or owner) or (owner or operator) of the above-described well,  
being first duly sworn on oath, says: That I have knowledge of the facts, statements, and matters herein contained and the log of the above-described well as filed and that the same are true and correct. So help me God.

(Signature) I. O. W. Keyes  
Ellinwood, Kansas. (Address)

SUBSCRIBED AND SWORN to before me this first day of December, 1915

My commission expires July 7, 1918 J. J. Rader Notary Public.

WELL LOG

W. L. Hartman et al - Anschutz #1  
 SE SE NW Section 11, Township 21 S, Range 14 W  
 Stafford County, Kansas

Figures indicate bottom of formation

Pipe: 8 5/8" set at 350'

0	to	310	Sand
		350	Shale
		358	Red bed
		508	Red bed and shale
		820	Red bed
		850	Anhydrite
		1085	Shale and shells
		1320	Salt and shale
		1700	Shale and shells
		1740	Line
		1885	Broken Line
		2000	Line and shale
		2095	Broken Line
		2330	Shale and Line
		2495	Broken Line
		2600	Line and shale
		2745	Shale and shells
		3000	Line
		3120	Line and shale
		3230	Line
		3348	Line and shale
		3604	Line
		3635	Chert
		3694	Simpson and Shale
		3750	Line
		3750	S. O., D. and A.

Tops:  
 Elevation 1921'

Brown Line 3348  
 White Line 3365  
 Chert 3604  
 Simpson 3635  
 Arbuckle 3694

Rotary spudded November 16, 1945  
 Rotary completed November 29, 1945

State of Kansas )  
 ss  
 County of Barton)

I, I. J. Rader, employee of drilling contractor of the above-described well, being first duly sworn on oath, declare: That I have knowledge of the facts, statements, and matters herein contained and the log of the above-described well as filed and that the same are true and correct.

*I. J. Rader*  
 STATE DEPARTMENT  
 DIVISION  
 DEC 3 1945  
 COMMISSIONER  
 ENERGY

Subscribed and Sworn to before me this third day of December, 1945.

11 21 14W  
 35 27

Notary Public

My commission expires July 6, 1948.