


STATE OF KANSAS
STATE CORPORATION COMMISSION

WELL PLUGGING RECORD

Give All Information Completely
Make Required Affidavit
Mail or Deliver Report to:
Conservation Division
State Corporation Commission
800 Bittling Building
Wichita, Kansas

Stafford County. Sec. 8 Twp. 21S Rge. 14 (W) (NW)
Location as "NE/CNW%SW%" or footage from lines NE SE NW
Lease Owner Jayhawk Drilling Co., Inc.
Lease Name Barrett Well No. 1
Office Address Box 2240 Wichita, Kansas
Character of Well (completed as Oil, Gas or Dry Hole) Dry
Date well completed February 1, 1954
Application for plugging filed February 1, 1954
Application for plugging approved February 1, 1954
Plugging commenced February 2, 1954
Plugging completed February 2, 1954
Reason for abandonment of well or producing formation Dry

NORTH

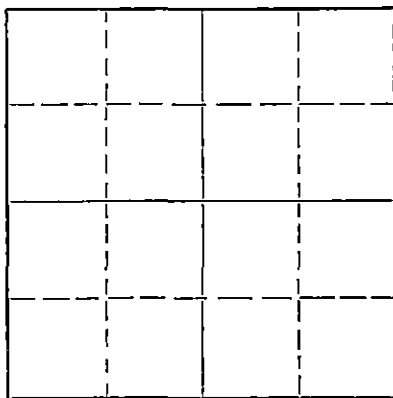

Locate well correctly on above
Section Plat

If a producing well is abandoned, date of last production 19
Was permission obtained from the Conservation Division or its agents before plugging was commenced? Yes

Name of Conservation Agent who supervised plugging of this well Mr. M. A. Rives Pratt, Kansas
Producing formation _____ Depth to top _____ Bottom _____ Total Depth of Well 3680 Feet
Show depth and thickness of all water, oil and gas formations.

OIL, GAS OR WATER RECORDS

CASING RECORD

FORMATION	CONTENT	FROM	TO	SIZE	PUT IN	PULLED OUT
				8 5/8"	867	none

Describe in detail the manner in which the well was plugged, indicating where the mud fluid was placed and the method or methods used in introducing it into the hole. If cement or other plugs were used, state the character of same and depth placed, from _____ feet to _____ feet for each plug set.

Filled hole w/ mud to 300', set plug @ 300', dump 20 sx cement on plug.

Fill w/ mud to 40', set plug @ 40', dump 10 sx cement on plug.

2-24-54

(If additional description is necessary, use BACK of this sheet)

Name of Plugging Contractor Jayhawk Drilling Co., Inc.
Address Box 2240 Wichita, Kansas

STATE OF Kansas, COUNTY OF Sedgwick, ss.

John M. Little (employee of owner) or (owner or operator) of the above-described well, being first duly sworn on oath, says: That I have knowledge of the facts, statements, and matters herein contained and the log of the above-described well as filed and that the same are true and correct. So help me God.


(Signature)

John M. Little
Box 2240 Wichita, Kansas
(Address)

SUBSCRIBED AND SWORN to before me this 18 day of February, 19 54

My commission expires August 13, 1957

Allen P. Denton
Notary Public.

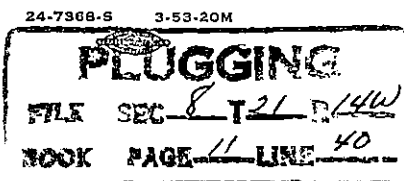

JAYHAWK DRILLING CO., INC.

Barrett, Well #1
NE SE NW Sec. 8-21S-14W
Stafford County, Kansas

Casing Record:
8 5/8" @ 867' w/ 400 sx.

Commenced: January 20, 1954
Completed: February 2, 1954

Elevation: 1935 R.B.
D. & A.

LOG

Surface Soil, Sand & Shale	0-160
Shale & Shells	160-400
Sand	400-500
Red Beds	500-863
Anhydrite	863-890
Red Beds, Shale & Shells	890-1285
Shale & Shells	1285-1380
Shale & Salt	1380-1540
Lime & Shale	1540-3063
Lime	3063-3101
Lime & Shale	3101-3226
Shale black	3226-3230
Lime	3230-3234
Shale	3234-3239
Lime	3239-3256
Shale	3256-3329
Lime	3329-3335
Shale	3335-3339
Lime	3339-3543
Lime & Shale	3543-3578
Chert	3578-3610
Shale, Sandy Shale	3610-3658
Chert & Shale	3658-3662
Dolomite	3662-3680 T.D.

D.S.T. 3666-3680 good blow, open 20 min.
Recovered 2160' water. F.P. 215#-954#
S.I.P. 1163#/15 min.

Tops:

	Sample	Schlumberger
Heebner	3226	3222
Toronto	3239	3236
Douglas	3256	3253
Brown lime	3329	3325
Lansing	3339	3335
Viola	3578	3574
Simpson shale	3610	3606
Arbuckle	3658	3654
T.D.	3680	3673

I hereby certify that this Log is true and correct to the best of my knowledge and belief.

JAYHAWK DRILLING COMPANY, INC.

BY Lyle Thomas

Sworn and subscribed to before me this 23 day of February, 1954.

Allen P. Denton
Notary Public

My Commission Expires August 13, 1957.

