


Give All Information Completely
Make Required Affidavit
Mail or Deliver Report to:
Conservation Division
State Corporation Commission
212 No. Market
Wichita, Kansas

WELL PLUGGING RECORD

NORTH

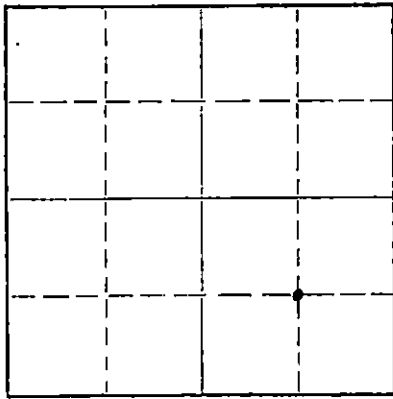

Locate well correctly on above
Section Plat

Barton County, Sec. 21 Twp. 16 Rge. (E) 12 (W)
Location as "NE/CNW/SW" or footage from lines SE/4
Lease Owner Duke Drilling Company
Lease Name Stoskopf Well No. 1
Office Address Box 823, Great Bend, Kansas 67530
Character of Well (completed as Oil, Gas or Dry Hole) oil
Date well completed March 12 19 57
Application for plugging filed May 22 19 69
Application for plugging approved 19
Plugging commenced May 28 19 69
Plugging completed June 2 19 69
Reason for abandonment of well or producing formation depleted

If a producing well is abandoned, date of last production 19
Was permission obtained from the Conservation Division or its agents before plugging was commenced? yes

Name of Conservation Agent who supervised plugging of this well Donald Truan
Producing formation Depth to top Bottom Total Depth of Well 3420' Feet
Show depth and thickness of all water, oil and gas formations.

OIL, GAS OR WATER RECORDS

CASING RECORD

FORMATION	CONTENT	FROM	TO	SIZE	PUT IN	PULLED OUT
		0	301'	8 5/8"	301'	none
		0	3420'	5 1/2"	3420'	983.21

Describe in detail the manner in which the well was plugged, indicating where the mud fluid was placed and the method or methods used in introducing it into the hole. If cement or other plugs were used, state the character of same and depth placed, from feet to feet for each plug set.

Plugged back from 3420' to 3340' with 5 sacks of cement.

Pushed plug to 300', set 10' rock bridge and dumped 5 sacks of cement.
Bailed down hole from 190' to 285' and dumped 20 sacks of cement on
bridge. Filled hole with mud to 40', set 10' rock bridge and capped
hole with 10 sacks of cement.

RECEIVED
STATE CORPORATION COMMISSION
JUN 6 1969
CONSERVATION DIVISION
Wichita, Kansas

(If additional description is necessary, use BACK of this sheet)

Name of Plugging Contractor Pipe Pullers, Inc.
Address Box 486, Ellinwood, Kansas

STATE OF Kansas, COUNTY OF Barton, ss.
Evelyn Roth


(employee of owner) or (owner-or-operator) of the above-described well, being first duly sworn on oath, says: That I have knowledge of the facts, statements, and matters herein contained and the log of the above-described well as filed and that the same are true and correct. So help me God.

(Signature) Evelyn Roth
Ellinwood, Kansas

(Address)

SUBSCRIBED AND SWORN to before me this 5th day of June, 19 69

My commission expires December 1, 1969

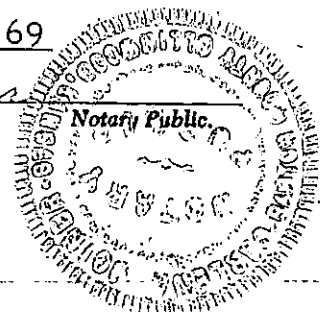

WELL LOG

Date Started: March 1, 1957
Date Completed: March 12, 1957

Stoskopf No. 1
SE/4
21-16S-12W
Barton County, Kansas

15-009-01255-00-00

Elevation	1919 K.B.
Anhydrite	814' (-1105)
Howard	2678' (-758)
Topeka	2716' (-797)
Heebner	2997' (-1078)
Toronto	3016' (-1097)
Douglas	3032' (-1113)
Iatan	3083' (-1164)
Lansing	3101' (-1182)
Conglomerate	3346' (-1427)
Arbuckle	3364' (-1445)
R.T.D.	3420' (-1501)

5 1/2" set at 3420'
8 5/8" set at 301'

175 CEMENT

PERFS AT-3366

0 -	30'	Surface Clay
30' -	80'	Shale and Rock
80' -	90'	Sand
90' -	110'	Shale
110' -	120'	Sand
120' -	270'	Shale
270' -	285'	Sand
285' -	301'	Blue Shale
301' -	310'	Shale
310' -	325'	Sand
325' -	530'	Shale
530' -	814'	Red Bed
814' -	838'	Anhydrite
838' -	915'	Shale and Shell
915' -	1225'	Shale and Shell
1225' -	1400'	Salt and Shale
1400' -	1450'	Shale and Shell
1450' -	1690'	Shale and Shell
1690' -	1885'	Lime
1885' -	2005'	Broken Lime
2005' -	2070'	Lime and Shale
2070' -	2580'	Lime and Shale
2580' -	2705'	Lime and Shale
2705' -	2835'	Lime
2835' -	2997'	Lime
2997' -	3060'	Heebner
3060' -	3101'	Lime
3101' -	3180'	Lansing
3180' -	3245'	Lime
3245' -	3335'	Lime
3335' -	3364'	Lime
3364' -	3420'	Arbuckle
3420'		R.T.D.

RECEIVED
STATE CORPORATION COMMISSION
MAY 23 1969
CONSERVATION DIVISION
Wichita, Kansas

AFFIDAVIT

State of Kansas County of Barton

I, Cecil M. Olson, employee of the owner, do swear that the
statements and matter herein contained are true to the best of my knowledge.

THE DUKE DRILLING COMPANY

BY: C. Olson

Subscribed and sworn before me this 10th day of April, 1957.

Chas E. Stevenson
NOTARY PUBLIC

My commission expires: June 24, 1959.