15-009-06373-00-00

STATE OF KANSAS
STATE CORPORATION COMMISSION

Give All Information Completely
Make Required Affidavit
Mail or Deliver Report to:
Conservation Division
State Corporation Commission
800 Bitting Building
Wichita, Kansas

WELL PLUGGING RECORD

OR

FORMATION PLUGGING RECORD

Strike out upper line when reporting plugging off formations.

NORTH

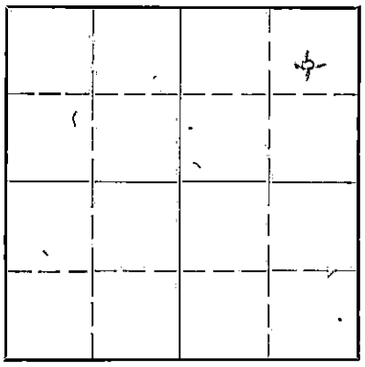

Locate well correctly on above Section Plat

Barton County. Sec. 21 Twp. 16 Rge. (E) 12 (W)

Location as "NE¼NW¼SW¼" or footage from lines CSL NE NE

Lease Owner The Bay Petroleum Corporation

Lease Name Stoskopf Well No. 1

Office Address 1006 Brown Bldg., Wichita, Kansas

Character of Well (completed as Oil, Gas or Dry Hole) Dry Hole

Date well completed October 26 19 43

Application for plugging filed October 26 19 43

Application for plugging approved October 26 19 43

Plugging commenced October 26 19 43

Plugging completed October 26 19 43

Reason for abandonment of well or producing formation Dry

If a producing well is abandoned, date of last production ..... 19 .....

Was permission obtained from the Conservation Division or its agents before plugging was commenced? yes

Name of Conservation Agent who supervised plugging of this well C. T. Alexander

Producing formation ..... Depth to top ..... Bottom ..... Total Depth of Well 3432 Feet

Show depth and thickness of all water, oil and gas formations.

OIL, GAS OR WATER RECORDS — CASING RECORD

Formation	Content	From	To	Size	Put In	Pulled Out
Surface		0	311	8-5/8" OD	311	none

Describe in detail the manner in which the well was plugged, indicating where the mud fluid was placed and the method or methods used in introducing it into the hold. If cement or other plugs were used, state the character of same and depth placed, from ..... feet to ..... feet for each plug set.

Hole was mudded from 3432' to 311'

Cemented from 311' to 265'

Mudded from 265' to 20'

Cemented from 20' to base of cellar

11-17-43

PLUGGING
Fil. 21 16-12W
BOOK PAGE 96 LINE 6

NOV 1

(If additional description is necessary, use BACK of this sheet)

Correspondence regarding this well should be addressed to The Bay Petroleum Corporation

Address 1006 Brown Bldg., Wichita, Kansas

STATE OF Kansas, COUNTY OF Sedgwick, ss.

Forrest Crawford (employee of owner) or (owner or operator) of the above-described well, being first duly sworn on oath, says: That I have knowledge of the facts, statements, and matters herein contained and the log of the above-described well as filed and that the same are true and correct. So help me God.

(Signature) Forrest Crawford

(Address)

SUBSCRIBED AND SWORN TO before me this 16th day of November, 19 43

Mary Dingler
Notary Public.

My commission expires Nov. 2, 1946

19-6929 4-43—6M

WELL LOG BUREAU - KANSAS GEOLOGICAL SOCIETY
412 Union National Bk Bldg., Wichita, Kansas

15-009-06373-00-00

BAY PETROLEUM CORP.
Stoskopf No. 1.

SEC. 21 T. 16 R. 12 W
CSL NE NE

Total Depth. 3432'
Comm. 10-8-43 Comp. 10-26-43
Shot or Treated.
Contractor.
Issued. 11-13-43

County. Barton

CASING:
8 5/8" 311'

Elevation.

Production. Dry

Figures Indicate Bottom of Formations.

shale & shells	193
sand & shale strks	276
shale & shells	700
shale red	805
anhydrite	842
shale & shells	1230
shale	1254
salt & shale strks	1471
anhydrite	1500
anhydrite & shale	1714
shale	1720
shale & shells	1779
lime brkn	1795
shale & lime	1814
shale	1837
lime	1872
lime & shale	1898
lime brkn	1970
lime & shale	2005
shale	2112
lime & shale	2400
lime	2440
shale	2481
lime & shale	2596
lime brkn	2653
lime & shale	2691
lime sft sdy	2696
lime	2785
lime & shale	2804
lime cherty	2831
lime	3055
shale	3070
lime	3194
lime sft	3219
lime	3244
lime & shale	3260
lime	3372
conglomerate	3400
dolomite	3432
Total Depth.	

Tops: Anhydrite	805
Topeka	2728?
Heebner	3011
Base Oread	3038
Brown Lansing	3095
White Lansing	3103
Base Kansas City	3365
Conglomerate	3370
Gorham Sd	3383
Core 3385-88 rec.2'4" fine to coarse grained sd Few oil stains,wtr	
Arbuckle	3393
Pre-Cambrian?	3420

31 16 12W
96 6

STATE OF KANSAS)
SS
COUNTY OF SEDGWICK)

This is to certify that the above is a true and correct copy of the Log of Stoskopf No. 1 described above.

Lowell Crawford
Ass't. Superintendent of Production of the Bay Petroleum Corporation

Subscribed and sworn to before me this 16th day of November, 1943.

Mary Kingler
(Notary Public)

My Com. Exp.
Nov. 2, 1946.