


STATE OF KANSAS
STATE CORPORATION COMMISSION
Give All Information Completely
Make Required Affidavit
Mail or Deliver Report to:
Conservation Division
State Corporation Commission
800 Bittling Building
Wichita, Kansas

OR
FORMATION PLUGGING RECORD

Strike out upper line
when reporting plug-
ging off formations.

NORTH

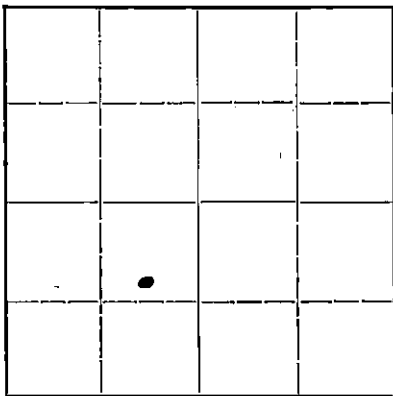

Locate well correctly on above
Section Flat

Barton County. Sec 21 Twp 16 Rge (E) 12 (West)
Location as "NE 1/4 NW 1/4 SW 1/4" or footage from lines C S 1/2 NE 1/2 SW 1/2
Lease Owner Sharon Drilling Company, Inc.
Lease Name Norton Well No 1
Office Address 352 North Broadway, Wichita, Kansas
Character of Well (completed as Oil, Gas or Dry Hole)
Date well completed January 31, 19 43
Application for plugging filed January 31, 19 43
Application for plugging approved January 31, 19 43
Plugging commenced January 31, 19 43
Plugging completed February 1, 19 43
Reason for abandonment of well or producing formation Dry hole
If a producing well is abandoned, date of last production 19
Was permission obtained from the Conservation Division or its agents before plugging was com-
menced? Yes

Name of Conservation Agent who supervised plugging of this well C. T. Alexander
Producing formation Arbuckle Depth to top 3396 Bottom Total Depth of Well 3430 Feet
Show depth and thickness of all water, oil and gas formations.

OIL, GAS OR WATER RECORDS

CASING RECORD

Formation	Content	From	To	Size	Put In	Pulled Out
Sand	Water	150	175	8 5/8"	197'	None

Describe in detail the manner in which the well was plugged, indicating where the mud fluid was placed and the method or methods used in introducing it into the hole. If cement or other plugs were used, state the character of same and depth placed, from feet to feet for each plug set.

Mud 3430' To 280'
Bridged hole at 280'
Cement 280' To 235'
Mud 235' To 26' Bridged at 26'
Cement 26' To 6'
6' To 0' Cellar

21 16 12W
63 20

(If additional description is necessary, use BACK of this sheet)
Correspondence regarding this well should be addressed to Sharon Drilling Company, Inc.,
Address 352 North Broadway, Wichita, Kansas

STATE OF Kansas, COUNTY OF Sedgwick, ss.
D. S. Cates (employee of owner) or (owner) of the above-described well,
being first duly sworn on oath, says: That I have knowledge of the facts, statements, and matters herein contained and the log of the above-described well as filed and that the same are true and correct. So help me God.

(Signature) D. S. Cates
Wichita, Kansas (Address)

SUBSCRIBED AND SWORN to before me this 3rd day of February, 19 43 2-4-43

My commission expires May 4-1943
Emma Schidlowich
Notary Public.

15-009-06553-00-00

Sharon, etal., #1 Norton
Elevation: 1924
Commenced: 1/14/43
Completed: 1/31/43
T. D. - 3430'

Center s¹/₂ NE¹/₄ SW¹/₄
Section 21-T16 S-R12 W
Barton County, Kansas

197 feet 8 5/8" surface casing. Cemented w/ 100 sacks cement

L O G.

Surface	10'
Clay	30
Post rock	50
Shale & shells	520
Red rock	680
Sand & red bed	835
Anhydrite	865
Shale & shells	1285
Shale & shells & salt	1440
Shale salt	1482
Broken lime	1730
Lime & sand	1815
Broken lime	1865
Sand	1885
Lime	1895
Broken lime	1985
Lime	2030
Broken lime	2170
Shale & shells	2700
Broken lime	2785
Lime	3043
Shale & shells	3070
Shale	3117
Lime	3201
Soft lime	3226
Lime	3335
Lime & shale	3384
Conglomerate & shale	3396
Arbuckle lime - top	3396
Arbuckle lime	3403
Chert & lime	3410
Lime	3430'

Geological Tops

Anhydrite Correct	839
Ft. Riley	1770
Lansing	3117
Chert Conglomerate	3381
Arbuckle dol	3396

I hereby certify that the foregoing is to the best of my knowledge and belief true and correct.

M. J. Bear

STATE OF KANSAS)
) SS
COUNTY OF SEDGWICK)

Subscribed and sworn to before me a notary public in and for the State and County aforesaid on this 3 day of February 1943.

My Commission Expires May 4-1943

Emma S. Holloway
Notary Public

21 16 124
63 20