

STATE OF KANSAS
STATE CORPORATION COMMISSION

Form CP-4

WELL PLUGGING RECORD

Give All Information Completely
Make Required Affidavit
Mail or Deliver Report to:
Conservation Division
State Corporation Commission
212 No. Market
Wichita, Kansas

Hodgeman County, Sec. 5 Twp. 21S Rge. (E) 23 (W)

NORTH 23W

Location as "NE/CNW/SW" or footage from lines NW NE

Lease Owner Rains & Williamson Oil Co., Inc.

Lease Name FRUSHER Well No. 1

Office Address 1425 Wichita Plaza - Wichita, Kansas

Character of Well (completed as Oil, Gas or Dry Hole) Dry Hole

Date well completed 7-1 19 67

Application for plugging filed 7-1 19 67

Application for plugging approved 7-1 19 67

Plugging commenced 7-1 19 67


Plugging completed 7-1 19 67

Reason for abandonment of well or producing formation No oil or gas

found in commercial quantities.

If a producing well is abandoned, date of last production -- 19 --

Was permission obtained from the Conservation Division or its agents before plugging was commenced? Yes

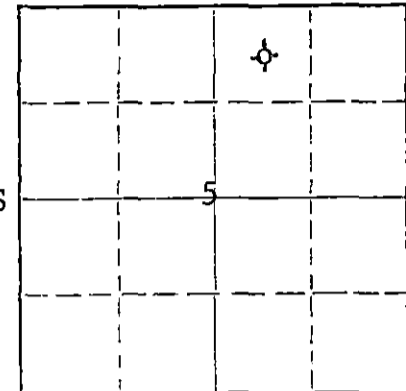

Locate well correctly on above Section Plat

Name of Conservation Agent who supervised plugging of this well Ed Eves, Sublette, Kansas

Producing formation Depth to top Bottom Total Depth of Well 4448 Feet

Show depth and thickness of all water, oil and gas formations.

OIL, GAS OR WATER RECORDS

CASING RECORD

FORMATION	CONTENT	FROM	TO	SIZE	PUT IN	PULLED OUT
				8-5/8"	251.48'	-0-

Describe in detail the manner in which the well was plugged, indicating where the mud fluid was placed and the method or methods used in introducing it into the hole. If cement or other plugs were used, state the character of same and depth placed, from feet to feet for each plug set.

Pushed plug to 700'. Spotted 30 sacks cement. Mud back to 300'. Spotted 30 sacks cement. Mud back to 40' and capped with 15 sacks cement. Plugging completed at 6:20 A.M. July 1, 1967.

RECEIVED
STATE CORPORATION COMMISSION
JUL 7 1967
7-7-67
CONSERVATION DIVISION
Wichita, Kansas

(If additional description is necessary, use BACK of this sheet)
Name of Plugging Contractor Rains & Williamson Oil Co., Inc.
Address 1425 Wichita Plaza - Wichita, Kansas 67202

STATE OF KANSAS, COUNTY OF SEDGWICK, ss.

Wilson Rains (owner or operator) of the above-described well, being first duly sworn on oath, says: That I have knowledge of the facts, statements, and matters herein contained and the log of the above-described well as filed and that the same are true and correct. So help me God.

(Signature) Wilson Rains
1425 Wichita Plaza - Wichita, Kansas

(Address)

SUBSCRIBED AND SWORN TO before me this 6 day of July, 19 67

My commission expires March 3, 1970 Mary J. Brown Notary Public.

ROTARY DRILLING LOG

Operator: Rains & Williamson
Oil Co., Inc.
#1 FRUSHER
NW NE Section 5-21S-23W
Hodgeman County, Kansas

Contractor: Rains & Williamson
Oil Co., Inc.
Commenced: 6-20-67
Completed: 7-1-67

Remarks: Set 8-5/8" surface
casing at 258.48'
w/170 sacks GL-3
cement.

Formations:

Surface Soil	40'
Shale and Shells	260'
Shale	335'
Shale and Red Bed	846'
Blaine Anhydrite	860'
Shale and Shells	1200'
Shale	1473'
Anhydrite	1512'
Shale and Shells	2055'
Shale and Lime	2470'
Lime	2825'
Lime and Shale	3110'
Shale	3305'
Shale and Lime	3775'
Lime	4399'
Chert	4427'
Chert and Lime	4448'
Rotary Total Depth (D & A)	4448'

RECEIVED
STATE CORPORATION COMMISSION

JUL 7 1967

CONSERVATION DIVISION
Wichita, Kansas

We certify the above log is
true and correct to the best
of our knowledge and belief.

RAINS & WILLIAMSON OIL CO., INC.


Wilson Rains

Subscribed and sworn to before me, a Notary Public within the State of Kansas,
County of Sedgwick, this 6th day of July, 1967.


Mary J. Brown Notary Public

My Commission Expires: 3-3-70