

STATE OF KANSAS
STATE CORPORATION COMMISSION
Give All Information Completely
Make Required Affidavit
Mail or Deliver Report to:
Conservation Division
State Corporation Commission
800 Bitting Building
Wichita, Kansas


WELL PLUGGING RECORD

OR

FORMATION PLUGGING RECORD

Strike out upper line
when reporting plug-
ging of formations.

Stafford County, Sec. 35 Twp. 21 Rge. 14 (E) (W)
Location as "NE $\frac{1}{4}$ NW $\frac{1}{4}$ SW $\frac{1}{4}$ " or footage from lines NW NW NE/4
Lease Owner S. A. Murphy
Lease Name Spangenberg Well No. 1
Office Address 701 Brown Bldg., Wichita 2, Kans.
Character of Well (completed as Oil, Gas or Dry Hole) Dry hole
Date well completed May 5, 19 50
Application for plugging filed May 5, 19 50
Application for plugging approved May 5, 19 50
Plugging commenced May 5, 19 50
Plugging completed May 5, 19 50
Reason for abandonment of well or producing formation.....
If a producing well is abandoned, date of last production..... 19 50
Was permission obtained from the Conservation Division or its agents before plugging was com-
menced? yes

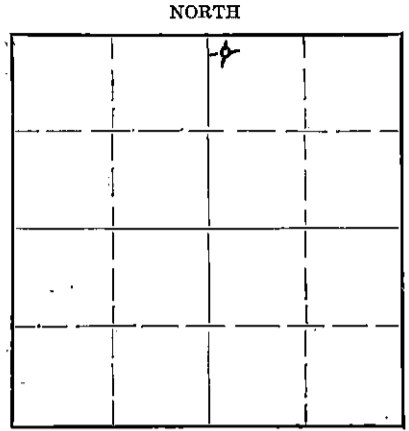

Name of Conservation Agent who supervised plugging of this well C. D. Stough
Producing formation..... Depth to top..... Bottom..... Total Depth of Well 3880 Feet
Show depth and thickness of all water, oil and gas formations.

| OIL, GAS OR WATER RECORDS | | | | CASING RECORD | | |
|---------------------------|---------|------|-----|---------------|--------|------------|
| Formation | Content | From | To | Size | Put In | Pulled Out |
| | | 0 | 424 | 8 5/8" | 424 | none |
| | | | | | | |
| | | | | | | |
| | | | | | | |
| | | | | | | |
| | | | | | | |
| | | | | | | |
| | | | | | | |
| | | | | | | |

Describe in detail the manner in which the well was plugged, indicating where the mud fluid was placed and the method or methods used in introducing it into the hole. If cement or other plugs were used, state the character of same and depth placed, from..... feet to..... feet for each plug set.

Mud to 215 ft. - set plug with 15 sx cement
Mud to 25 ft. - set plug with 10 sx cement

5-9-50
Conservation Div.
MAY 9 - 1950
STATE CORPORATION COMMISSION
KANSAS

(If additional description is necessary, use BACK of this sheet)
Correspondence regarding this well should be addressed to Virginia Drlg Co. Inc.
Address 701 Brown Bldg., Wichita 2, Kansas


STATE OF Kansas COUNTY OF Sedgwick, ss.

S. A. Murphy (employee of owner) or (owner or operator) of the above-described well, being first duly sworn on oath, says: That I have knowledge of the facts, statements, and matters herein contained and the log of the above-described well as filed and that the same are true and correct. So help me God.

(Signature) S. A. Murphy
701 Brown Bldg., Wichita 2, Kansas
(Address)

SUBSCRIBED AND SWORN to before me this 8th day of May, 19 50.
Inez M. Newman
Notary Public.

My commission expires March 15, 1954

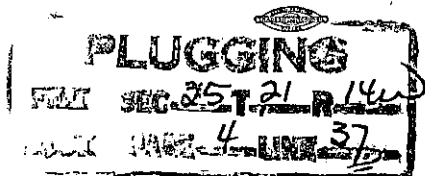

15.185.00641.0000

Well: Spangenberg No. 1
 Location: NW NW NE Section 35-21-14, Stafford County, Kansas
 Company: S. A. Murphy
 Contractor: Virginia Drilling Co., Inc.
 Commenced: April 16, 1950
 Completed: May 5, 1950
 Total Depth: 3880
 Elevation: 1933 DF

| FORMATION | DEPTH |
|--------------|-----------|
| Cellar | 0-7 |
| Sand | 7-225 |
| Shale grey | 225-360 |
| Red Bed-sand | 360-425 |
| Red Bed | 425-825 |
| Anhydrite | 825-850 |
| Shale-shells | 850-1330 |
| Salt | 1330-1400 |
| Shale | 1400-1480 |
| Shale-shells | 1480-1615 |
| Brk. Lime | 1615-1720 |
| Sand & Lime | 1720-1730 |
| Lime-shale | 1730-1970 |
| Lime | 1970-1980 |
| Lime-shale | 1980-2300 |
| Shale-shells | 2300-2335 |
| Lime-shale | 2335-2930 |
| Lime | 2930-2935 |
| Lime-shale | 2935-3072 |
| Lime | 3072-3353 |
| Lime-shale | 3353-3438 |
| Lime | 3438-3490 |
| Lime K.C. | 3490-3528 |
| Lime | 3528-3720 |
| Conglomerate | 3720-3740 |
| Cherty | 3740-3787 |
| Lime-Chert | 3787-3793 |
| Shale | 3793-3840 |
| Lime & Shale | 3840-3853 |
| Lime | 3853-3880 |

Set 8-5/8" csg. @ 424'

TOPS:

| | |
|-------------------|------|
| Heebner | 3313 |
| Dodge | 3340 |
| Brown Lime | 3427 |
| Lansing K. C. | 3438 |
| Base Lansing | 3700 |
| Sooy Conglomerate | 3726 |
| Viola | 3741 |
| Simpson | 3792 |
| Arbuckle | 3841 |

Now comes S. A. Murphy, who states that he is familiar with the drilling of oil and gas wells and knows of his own knowledge that the Spangenberg No. 1, located in the NW NW NE Section 35-21-14, Stafford County, Kansas, was drilled to a total depth of 3880 feet. Same was plugged and abandoned.

Subscribed and sworn to before me this 8th day of May, 1950.

S. A. Murphy

Inez M. Newman

My commission expires March 15, 1954.

PLUGGING
 FILE NO. 35-21-14-5
 BOOK PAGE 4 LINE 57

MAY 9 - 1950
 STATE CORPORATION
 COMMISSION
 KANSAS