

STATE OF KANSAS
STATE CORPORATION COMMISSION

WELL PLUGGING RECORD

Give All Information Completely
Make Required Affidavit
Mail or Deliver Report to:
Conservation Division
State Corporation Commission
800 Bitting Building
Wichita, Kansas


OR

FORMATION PLUGGING RECORD

Strike out upper line
when reporting plug-
ging of formations.

Stafford County. Sec. 35 Twp. 21S Rge. 14 (X) (W)

Location as "NE $\frac{1}{4}$ NW $\frac{1}{4}$ SW $\frac{1}{4}$ " or footage from lines SW NE SW
Lease Owner Petroleum, Inc.
Lease Name Matzek Well No. 1
Office Address 100 Derby Building, Wichita 2, Kansas
Character of Well (completed as Oil, Gas or Dry Hole) Dry hole
Date well completed May 30, 1950
Application for plugging filed June 3, 1950
Application for plugging approved June 1, 1950
Plugging commenced May 30, 1950
Plugging completed May 30, 1950
Reason for abandonment of well or producing formation Dry hole

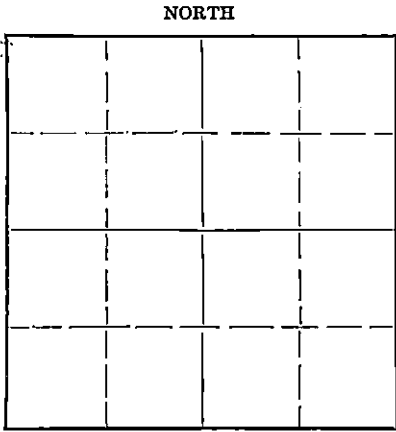

Locate well correctly on above
Section Plot

If a producing well is abandoned, date of last production _____ 19____
Was permission obtained from the Conservation Division or its agents before plugging was com-
menced? Yes

Name of Conservation Agent who supervised plugging of this well C. D. Stough
Producing formation _____ Depth to top _____ Bottom _____ Total Depth of Well 3825 Feet
Show depth and thickness of all water, oil and gas formations.

OIL, GAS OR WATER RECORDS

CASING RECORD

Formation	Content	From	To	Size	Put In	Pulled Out
				8 5/8"	239'	

Describe in detail the manner in which the well was plugged, indicating where the mud fluid was placed and the method or methods used in introducing it into the hole. If cement or other plugs were used, state the character of same and depth placed, from _____ feet to _____ feet for each plug set.

Filled hole to 239' with heavy mud, placed plug at 239'. Displaced through drill pipe 15 sacks of cement on top of plug. Filled hole to 35' with heavy mud, placed plug at 35'. Mixed and dumped 10 sacks of cement on top of plug filling hole to bottom of Cellar. **RECORDED**

6-6-50 JUN 6 X 1950

STATE CORPORATION
COMMISSION
KANSAS

(If additional description is necessary, use BACK of this sheet)

Correspondence regarding this well should be addressed to Petroleum, Inc.
Address 100 Derby Building Wichita 2, Kansas

STATE OF KANSAS COUNTY OF SEDGWICK, ss.


Eric H. Jager (employee of owner) ~~of~~ of the above-described well, being first duly sworn on oath, says: That I have knowledge of the facts, statements, and matters herein contained and the log of the above-described well as filed and that the same are true and correct. So help me God.

(Signature) Eric H. Jager
Executive Vice-President
100 Derby Building, Wichita, Kansas
(Address)

SUBSCRIBED AND SWORN to before me this 3rd day of June 1950.

commission expires October 27, 1952

Marjorie Bradshaw
Notary Public.

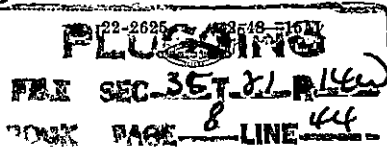

WELL LOG MATZEK # 1

Petroleum, Inc., Lease Owner

Section 35, Twp. 21S, Rage 14W

Garvey Oil, Contractor

Location: SW NE SW

Rotary Total Depth: 3825'
Cable Tool Depth:

County: Stafford, Kansas

Commenced: May 21, 1950

Production: Dry Hole

Completed: May 30, 1950

Elevation: 1934 D.F.

Casing: 242' of 8 5/8"

Figures below indicate bottom of formation:

260 Shale		
330 Sand		
660 Red Bed		
830 Sand & Shale		
855 Anhydrite		
950 Shale & Red Bed		
1235 Shale & Shells		
1690 Lime & Shale		
2345 Shale & Shells		
2515 Shale & Lime		
3458 Lime		
3681 Lime & Shale		
3693 Conglomerate		
3740 Chert		
3774 Shale		
3810 Lime & Shale		
3825 Lime		
3825 R.T.D.		
	<u>Tops</u>	
	830 Anhydrite	
	3291 Heebner	
	3314 Toronto	
	3330 B.O.	
	3412 Br. Lime	
	3422 Lansing	
	3638 B.K.C.	
	3680 P.B.C.	
	3699 Viola	
	3746 Simpson	
	3794 Arbuckle	
	<u>Shows of Oil</u>	
	3565-67	
	3631-38	
	3668-70	

I hereby certify that this is a true and correct log of the above mentioned well.

PETROLEUM, INC.

Eric H. Jager
Eric H. Jager

STATE OF KANSAS
: SS.
SEDGWICK COUNTY

JUN 6 X 1950

Subscribed to and sworn to before me, a Notary Public in said County and State this 3rd day of June, 1950.

Marjorie Bradshaw
Notary Public

My Commission Expires: October 27 1952

