


STATE OF KANSAS  
STATE CORPORATION COMMISSION

Form CP-4

Give All Information Completely  
Make Required Affidavit  
Mail or Deliver Report to:  
Conservation Division  
State Corporation Commission  
P. O. Box 17027  
Wichita, Kansas 67217  
NORTH

WELL PLUGGING RECORD

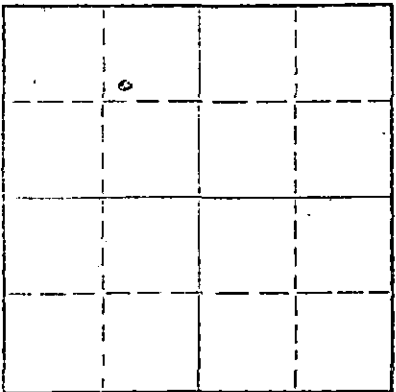

Locate well correctly on above  
Section Plat

Stafford County, Sec. 35 Twp. 21s Rge. 14 West (W)  
Location as "NE/CNWxSWx" or footage from lines SW/4 NE/4 NW/4  
Lease Owner A. Scott Ritchie  
Lease Name SPANGENBERG Well No. 1  
Office Address 412 Union Center Building, Wichita, Ks. 67202  
Character of Well (completed as Oil, Gas or Dry Hole) Dry Hole  
Date well completed October 10 1972  
Application for plugging filed October 10 1972  
Application for plugging approved October 10 1972  
Plugging commenced October 10 1972  
Plugging completed October 10 1972  
Reason for abandonment of well or producing formation

If a producing well is abandoned, date of last production 19  
Was permission obtained from the Conservation Division or its agents before plugging was commenced? Yes

Name of Conservation Agent who supervised plugging of this well Mr. G. Russell Biberstein  
Producing formation Depth to top Bottom Total Depth of Well 3833 Feet  
Show depth and thickness of all water, oil and gas formations.

OIL, GAS OR WATER RECORDS

CASING RECORD

FORMATION	CONTENT	FROM	TO	SIZE	PUT IN	PULLED OUT

Describe in detail the manner in which the well was plugged, indicating where the mud fluid was placed and the method or methods used in introducing it into the hole. If cement or other plugs were used, state the character of same and depth placed, from feet to feet for each plug set.

Hole full of heavy mud to 350'  
Set Plug, 75 sacks cement thru drill pipe  
Come up hole to 40' - Set Plug, 1/2 sack hulls, & 15 sacks cement  
2 sacks cement in rat hole

RECEIVED  
STATE CORPORATION COMMISSION  
10-12-72 OCT 12 1972  
CONSERVATION DIVISION  
Wichita, Kansas

(If additional description is necessary, use BACK of this sheet)

Name of Plugging Contractor  
Address

STATE OF KANSAS COUNTY OF Barton, ss.

Leonard Williamson (employee of owner) or (owner) of the above-described well, being first duly sworn on oath, says: That I have knowledge of the facts, statements, and matters herein contained and the log of the above-described well as filed and that the same are true and correct. So help me God.

(Signature) Leonard Williamson  
Box 823 - Great Bend, Kans. 67530  
(Address)

SUBSCRIBED AND SWORN TO before me this 11th day of October, 1972

Notary Public

My commission expires 4-11-1974

DRILLERS' WELL LOG

DATE COMMENCED: OCTOBER 3, 1972  
DATE COMPLETED: OCTOBER 10, 1972

A. Scott Ritchie  
SPANGENBERG #1  
SW/4 NE/4 NW/4  
Section 35, T21S0, R14W  
Stafford County, Kansas

ELEVATION: 1934 K.B.

0'-	214'	Sand & Clay
214'-	290'	Shale & Sand Streaks
290'-	495'	Sand & Shale Streaks
495'-	826'	Red Bed
826'-	851'	Anhydrite
851'-	1697'	Shale & Shells
1697'-	3298'	Lime & Shale
3298'-	3302'	Shale
3302'-	3319'	Lime & Shale
3319'-	3336'	Lime
3336'-	3419'	Shale
3419'-	3429'	Lime & Shale
3429'-	3641'	Lime
3641'-	3768'	Lime, Shale, Chert & Sand
3768'-	3818'	Shale & Sand
3818'-	3833'	Dolomite
	3833'	RTD

FORMATION DATA

ANHYDRITE	826
HEEBNER	3298
TORONTO	3319
DOUGLAS	3336
BROWN LIME	3419
KANSAS CITY	3429
BASE K.C.	3641
CONGLOMERATE	3704
VIOLA	3728
SIMPSON SHALE	3768
ARBUCKLE	3818

SURFACE PIPE: Set used 8-5/8"  
28# Casing at 233' with 215  
sacks cement.

A F F I D A V I T

STATE OF KANSAS  
COUNTY OF BARTON ) ss.

Leonard Williamson of lawful age, does swear and state that  
the facts and statements herein contained are true and correct to  
the best of his knowledge.

Leonard Williamson

Subscribed and sworn to before me this 11th day of October 1972.

Deborah M. Hague  
Notary Public

My Comm. Expires:  
April 11, 1974

RECEIVED  
STATE CORPORATION COMMISSION  
OCT 12 1972  
CONSERVATION DIVISION  
Wichita, Kansas