


WELL PLUGGING RECORD

Give All Information Completely
Make Required Affidavit
Mail or Deliver Report to:
Conservation Division
State Corporation Commission
212 North Market, Insurance Bldg.
Wichita, Kansas

Stafford County, Sec. 1 Twp. 21 Rge. 13 ~~XXX~~ (W)

Location as "NE/CNW%SW%" or footage from lines NW NE SW
Lease Owner Neven H. Veail
Lease Name Graham Well No. 1
Office Address 1401 McKinley, Great Bend, Kansas
Character of Well (completed as Oil, Gas or Dry Hole) Dry Hole
Date well completed Dec. 31, 1959 19
Application for plugging filed Dec. 30, 1959 19
Application for plugging approved Dec. 31, 1959 19
Plugging commenced " " " 19
Plugging completed " " " 19
Reason for abandonment of well or producing formation Dry Hole

NORTH

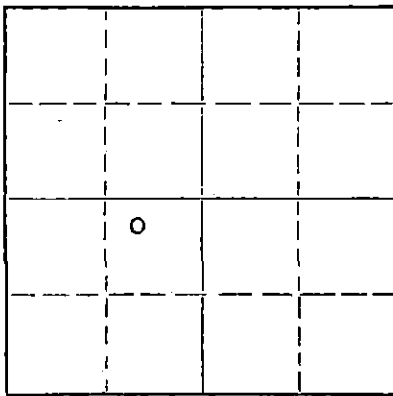

Locate well correctly on above
Section Plat

If a producing well is abandoned, date of last production _____ 19____
Was permission obtained from the Conservation Division or its agents before plugging was commenced? Yes

Name of Conservation Agent who supervised plugging of this well Frank Broadfoot
Producing formation _____ Depth to top _____ Bottom _____ Total Depth of Well 3604 Feet
Show depth and thickness of all water, oil and gas formations.

OIL, GAS OR WATER RECORDS

CASING RECORD

FORMATION	CONTENT	FROM	TO	SIZE	PUT IN	PULLED OUT
<u>Rotary Hole</u>						

Describe in detail the manner in which the well was plugged, indicating where the mud fluid was placed and the method or methods used in introducing it into the hole. If cement or other plugs were used, state the character of same and depth placed, from _____ feet to _____ feet for each plug set.

Filled hole with mud up to 200 ft. Set wooden plug and one half sack of hulls, then 20 sacks of common cement, then filled hole to 35 ft. with mud and set wooden plug and one quarter sack of hulls and then 10 sacks of cement.

(If additional description is necessary, use BACK of this sheet)
Name of Plugging Contractor Quivira Exploration Co.
Address P. O. Box 297, Great Bend, Kansas

STATE OF Kansas, COUNTY OF Barton, ss.
H. D. Jamison (employee of owner) or (owner or operator) of the above-described well, being first duly sworn on oath, says: That I have knowledge of the facts, statements, and matters herein contained and the log of the above-described well as filed and that the same are true and correct. So help me God.

(Signature) H. D. Jamison
Harrington, Kan (Address)

SUBSCRIBED AND SWORN TO before me this 5 day of Jan. 1960
My commission expires Oct 1, 1961
[Signature] Notary Public.

RECEIVED
STATE CORPORATION COMMISSION

JAN 13 1960

ATION DIVISION