


WELL PLUGGING RECORD

Give All Information Completely
Make Required Affidavit
Mail or Deliver Report to:
Conservation Division
State Corporation Commission
800 Bittling Building
Wichita, Kansas

Stafford County, Sec. 1 Twp. 21 Rge. 13 ~~XX~~ (W)
Location as "NE/CNW $\frac{1}{4}$ SW $\frac{1}{4}$ " or footage from lines SE. SE. NW
Lease Owner Derby Oil Company et al
Lease Name Gunn Well No. 1
Office Address 420 West Douglas, Wichita, Kansas,
Character of Well (completed as Oil, Gas or Dry Hole) Dry Hole
Date well completed January 3, 19 50
Application for plugging filed February 1, 19 50
Application for plugging approved January 30, 19 50
Plugging commenced January 22, 19 50
Plugging completed January 26, 19 50
Reason for abandonment of well or producing formation Dry Hole

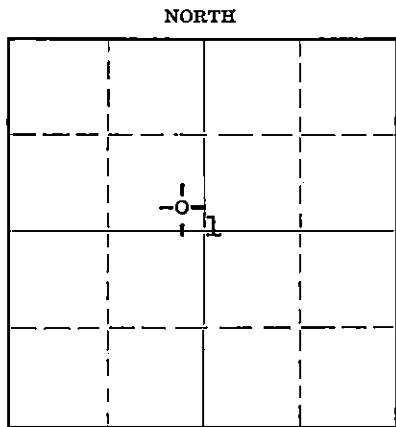

Locate well correctly on above Section Plat

If a producing well is abandoned, date of last production 19
Was permission obtained from the Conservation Division or its agents before plugging was commenced? Yes

Name of Conservation Agent who supervised plugging of this well Charles Stough
Producing formation None Depth to top Bottom Total Depth of Well 3561 Feet
Show depth and thickness of all water, oil and gas formations.

OIL, GAS OR WATER RECORDS

CASING RECORD

Formation	Content	From	To	Size	Put In	Pulled Out
				8 5/8"	225	None
				5 1/2"	3497	3000

Describe in detail the manner in which the well was plugged, indicating where the mud fluid was placed and the method or methods used in introducing it into the hole. If cement or other plugs were used, state the character of same and depth placed, from feet to feet for each plug set.

Rock 3561 - 3497
Cement 3497 - 3457
Mud 3457 - 280
Rock 280 - 225
Cement 225 - 180
Mud 180 - 46
Cement 46 - 6
Cellar 6 - 0

RECEIVED

FEB 7 X 1950 2-7-50

STATE

(If additional description is necessary, use BACK of this sheet)


Correspondence regarding this well should be addressed to Derby Oil Company
Address 420 West Douglas, Wichita, Kansas.

STATE OF Kansas, COUNTY OF Sedgwick, ss.
J. R. Bratcher (employee of owner) of the above-described well,
being first duly sworn on oath, says: That I have knowledge of the facts, statements, and matters herein contained and the log of the above-described well as filed and that the same are true and correct. So help me God.
(Signature) J. R. Bratcher, Engineer
Derby Oil Company, Wichita, Kansas.

SUBSCRIBED AND SWORN to before me this 1st day of February, 19 50

H. A. Bilson, Notary Public.

My commission expires August 24, 1953.

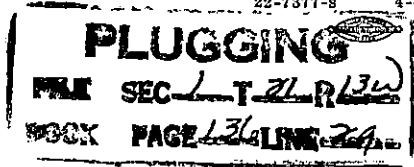

DRILLER'S LOG

Company: Derby Oil Company
 Mid-Plains Oil Corp.
 Peel-Hardman Producers

Sec. 1 Twp. 21S Rge. 13W
 SE SE NW

County: Stafford,
 Kansas

Farm: Gunn Well No. 1
 Total Depth: 3498' (Rotary)

Elevation:

Comm.: 12-13-49 Comp.: 12-24-49
 Contractor: Glenn Peel Drilling Co., Inc.

Casing:
 8 5/8" 223' cem.
 5 1/2" 3497' cem.

Production:

Figures below indicate bottom of formations

Surface Clay	0 -	100
Shale		180
Sand		200
Shale and Shells		225
Shale and Red Bed		400
Red Bed and Shale		690
Anhydrite		705
Shale and Shells		1575
Lime		1800
Lime and Shale		2315
Shale and Lime		2515
Lime and Shale		2655
Lime		2755
Lime and Shale		2855
Lime		3030
Hard Lime		3092
Lime		3498
Total Depth (Rotary)		3498

RECEIVED

This is to certify that the above information is, to the best of our knowledge, true and correct.

FEB 7 X 1950

GLENN PEEL DRILLING COMPANY, INC.
 COMMISSIONER
 KANSAS

BY: Mendell E. Peel

SUBSCRIBED AND SWORN to before me this 29th day of December, 1949.

My commission expires June 4, 1951
Marion M. Harbert
 Notary Public

PLUGGING
 FILE SEC-1 T-21 R-13W
 BOOK PAGE 136 LINE 29