


WELL PLUGGING RECORD

Give All Information Completely
Make Required Affidavit
Mail or Deliver Report to:
Conservation Division
State Corporation Commission
211 No. Broadway
Wichita, Kansas

Stafford County, Sec. 1 Twp. 21S Rge. 13W(E) (W)

Location as "NE/CNW%SW%" or footage from lines NE SW NE
Lease Owner ALPINE OIL & ROYALTY CO., INC.
Lease Name ADDRESS No. 1-C Well No.
Office Address 800 Bitting Bldg, Wichita, Ks.
Character of Well (completed as Oil, Gas or Dry Hole) dry hole
Date well completed April 2, 1962 19
Application for plugging filed April 2, 1962 19
Application for plugging approved April 2, 1962 19
Plugging commenced April 2, 1962 19
Plugging completed April 2, 1962 @ 8 A. M. 19
Reason for abandonment of well or producing formation non-productive

NORTH

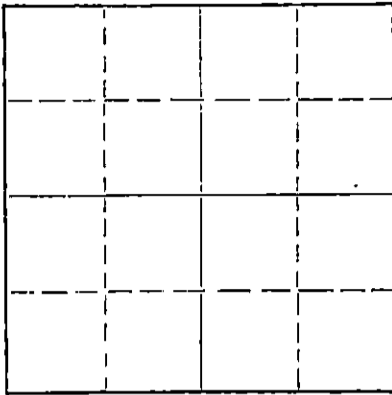

Locate well correctly on above
Section Plat

If a producing well is abandoned, date of last production 19
Was permission obtained from the Conservation Division or its agents before plugging was commenced? yes

Name of Conservation Agent who supervised plugging of this well W. L. Lackamp
Producing formation _____ Depth to top _____ Bottom _____ Total Depth of Well 3566 Feet
Show depth and thickness of all water, oil and gas formations.

OIL, GAS OR WATER RECORDS

CASING RECORD

FORMATION	CONTENT	FROM	TO	SIZE	PUT IN	PULLED OUT
				8 5/8"	242'	cemented

Describe in detail the manner in which the well was plugged, indicating where the mud fluid was placed and the method or methods used in introducing it into the hole. If cement or other plugs were used, state the character of same and depth placed, from _____ feet to _____ feet for each plug set.

Heavy mud from 3566 to 220 feet, plug and 25 sacks cement through drill pipe, mud to 35 feet, another plug and 10 sacks cement - 2 sacks in rat hole

RECEIVED
STATE CORPORATION COMMISSION

MAR 26 1963

CONSERVATION DIVISION
Wichita, Kansas

(If additional description is necessary, use BACK of this sheet)

Name of Plugging Contractor Quaker Drilling Co., Inc.
Address 800 Bitting Bldg, Wichita, Ks.

STATE OF Kansas, COUNTY OF Sedgwick, ss.
Thomas M. McCaul (employee of owner) or (owner or operator) of the above-described well, being first duly sworn on oath, says: That I have knowledge of the facts, statements, and matters herein contained and the log of the above-described well as filed and that the same are true and correct. So help me God.

(Signature) *Thomas M. McCaul*
800 Bitting Building, Wichita, Ks. (Address)

SUBSCRIBED AND SWORN TO before me this 10th day of April, 1962

My commission expires August 10, 1965

Virginia Murrell
Notary Public.

WELL LOG

ALPINE OIL & ROYALTY CO., INC.

Commenced: 3-24-62

Contractor: Quaker Drilling Co., Inc.

Completed: 4-2-62

Address No. 1-C
NE SW NE Sec. 1-21S-13W
Stafford County, Kansas

Elevation: 1857 KB

Production: D & A

Casing Record

8 5/8 inch casing set at 242 feet with 250 sacks cement

(Figures Indicate the Bottom of the Formations)

<u>FORMATION</u>	<u>DEPTH</u>	<u>FORMATION TOPS</u>	
Sand	170	Heebner	3096 -1239
Shale	242	Brown Lime	3223 -1366
Shale and Shells	375	Lansing	3235 -1378
Red Bed	530	Base of Kansas City	3459 -1602
Shale	680	Conglomerate	3468 -1611
Sanhydrite	705	Arbuckle	3513 -1656
Shale and Shells	1500	Rotary Total Depth	3566 -1709
Lime and Shale	1750		
Sandy Lime and Shale	1975		
Lime and Shale	2295		
Shale	2520		
Lime and Shale	2920		
Lime	3065		
Lime and Shale	3566		

We hereby certify the foregoing to be a true and correct copy of the driller's log of the well drilled in the NE SW NE of Section 1, Township 21 South, Range 13 West, Stafford County, Kansas.

QUAKER DRILLING CO., INC.

By:


 Thomas M. McCaul, President

SUBSCRIBED AND SWORN TO before me a Notary Public this 10th day of April, 1962.


 Virginia Mundell, Notary Public

MY COMMISSION EXPIRES:
August 10, 1965

RECEIVED
STATE CORPORATION COMMISSION

MAR 26 1963

CONSERVATION DIVISION
Wichita, Kansas