


STATE OF KANSAS
STATE CORPORATION COMMISSION

WELL PLUGGING RECORD

Give All Information Completely
Make Required Affidavit
Mail or Deliver Report to
Conservation Division
State Corporation Comm.
245 North Water
Wichita, KS 67202

Stafford County. Sec. 1 Twp. 21 Rge. 13 E/W
Location as "NE/CNW 1/4 SW 1/4" or footage from lines
NW NW NE

Lease Owner Roxana Corporation
Lease Name ADDRESS Well No. 1
Office Address P.O. Box 1162, Great Bend, Ks. 67530
Character of Well (Completed as Oil, Gas or Dry Hole) Dry Hole

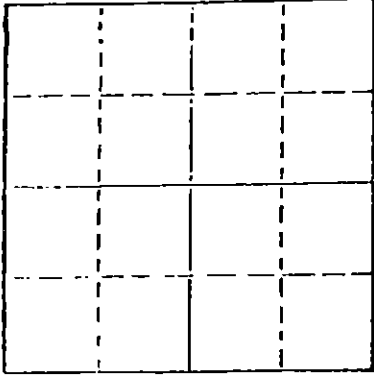

Locate well correctly on above
Section Plat

Date Well completed June 29, 1978
Application for plugging filed June 29, 1978
Application for plugging approved June 29, 1978
Plugging commenced June 29, 1978
Plugging completed June 29, 1978
Reason for abandonment of well or producing formation _____

If a producing well is abandoned, date of last production 19____

Was permission obtained from the Conservation Division or its agents before plugging was commenced? yes

Name of Conservation Agent who supervised plugging of this well William Owen
Producing formation _____ Depth to top _____ Bottom _____ Total Depth of Well 3585
Show depth and thickness of all water, oil and gas formations.

OIL, GAS OR WATER RECORDS

CASING RECORD

FORMATION	CONTENT	FROM	TO	SIZE	PUT IN	PULLED OUT

Describe in detail the manner in which the well was plugged, indicating where the mud fluid was placed and the method or methods used in introducing it into the hold. If cement or other plugs were used, state the character of same and depth placed, from _____ feet to _____ feet for each plug set.

Bottom plug @ 540' w/40 sacks cement thru drill pipe.
Middle plug @ 300' w/40 sacks cement thru drill pipe.
Top plug @ 40' w/1/2 sk hulls & 10 sacks cement.
2 sks. cement in rat hole.

RECEIVED
STATE CORPORATION COMMISSION

JUL 03 1978

CONSERVATION DIVISION
Wichita, Kansas

(If additional description is necessary, use BACK of this sheet)

Name of Plugging Contractor Duke Drilling Co., Inc.

STATE OF KANSAS COUNTY OF Barton, ss.
Leonard Williamson (employee of owner) or (owner or operator)
of the above-described well, being first duly sworn on oath, says: That I have knowledge of the facts, statements, and matters herein contained and the log of the above-described well as filed and that the same are true and correct. So help me God.

(Signature) Leonard Williamson
P.O. Box 823- Great Bend, Ks. 67530
(Address)

SUBSCRIBED AND SWORN TO before me this 30 day of June, 19 78

Dorothy M. Hague
Notary Public.

My commission expires 4-11 1982

DRILLERS' WELL LOG

DATE COMMENCED: June 22, 1978
DATE COMPLETED: June 29, 1978

Roxana Corporation
ADDRESS #1
NW NW NE
Sec. 1-T21-R13W
Stafford County, Kansas

1 - 213'	Surface Soil, Shale & Sand
213 - 249'	Shale
249 - 310'	Sand & Shale & Red Bed
310 - 343'	Shale & Red Bed
343 - 683'	Sand, Shale & Red Bed
683 - 704'	Anhydrite
704 - 2823'	Shale, Lime
2823 - 2859'	Lime
2859 - 2875'	Shale
2875 - 3096'	Lime
3096 - 3100'	Shale
3100 - 3114'	Shale & Lime
3114 - 3131'	Lime
3131 - 3221'	Shale
3221 - 3234'	Lime & Shale
3234 - 3450'	Lime
3450 - 3461'	Lime & Shale
3461 - 3482'	Lime, Shale, Chert
3482 - 3585'	Dolomite
	RTD

ELEVATION: 1858 K.S.

FORMATION DATA

ANHYDRITE	683
HOWARD	2823
SEVERY	2859
TOPEKA	2875
HEBENEE	3096
TORONTO	3114
DOUGLAS	3131
BR. LIME	3221
KANSAS CITY	3234
BASE K.S.	3450
CONGLOMERATE	3461
AREUCKLE	3482
RTD	3585

SURFACE PIPE: Set 310' of
6-5/8" used 28# pipe with
250 sacks 60/40 pozmix, 2% Gal,
3% cc.

A F F I D A V I T

STATE OF KANSAS
COUNTY OF BARTON) ss

Leonard Williamson, of lawful age, does swear and state that the facts
and statements herein contained are true and correct to the best of his knowledge.

Leonard Williamson
Leonard Williamson

Subscribed and sworn to before me this 30 day of June 1978

My Comm. Expires:
April 11 1982

Dorothy M. Lague
Notary Public

RECEIVED
STATE CORPORATION COMMISSION
JUL 03 1978

CONSERVATION DIVISION
Wichita, Kansas