


WELL PLUGGING RECORD

Give All Information Completely  
Make Required Affidavit  
Mail or Deliver Report to:  
Conservation Division  
State Corporation Commission  
800 Bittling Building  
Wichita, Kansas

Stafford County, Sec. 16 Twp. 21 Rge. 12 (E) (W)

NORTH

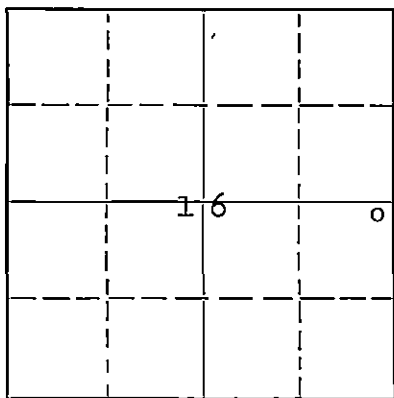

Locate well correctly on above  
Section Plat

Location as "NE/CNW $\frac{1}{4}$ SW $\frac{1}{4}$ " or footage from lines \_\_\_\_\_  
Lease Owner Buick Drilling Inc.  
Lease Name Olmstead Well No. 1  
Office Address St. John, Kansas  
Character of Well (completed as Oil, Gas or Dry Hole) Dry Hole  
Date well completed 12-7-51 19\_\_\_\_  
Application for plugging filed 12-7- 1951  
Application for plugging approved 12-7- 1951  
Plugging commenced 12-7- 1951  
Plugging completed 12-7- 1951  
Reason for abandonment of well or producing formation dry

If a producing well is abandoned, date of last production \_\_\_\_\_ 19\_\_\_\_  
Was permission obtained from the Conservation Division or its agents before plugging was commenced? YES

Name of Conservation Agent who supervised plugging of this well C. D. Stough  
Producing formation None Depth to top \_\_\_\_\_ Bottom \_\_\_\_\_ Total Depth of Well 3650 Feet  
Show depth and thickness of all water, oil and gas formations.

OIL, GAS OR WATER RECORDS

CASING RECORD

Formation	Content	From	To	Size	Put In	Pulled Out
		0	313	8 5/8	313	None

Describe in detail the manner in which the well was plugged, indicating where the mud fluid was placed and the method or methods used in introducing it into the hole. If cement or other plugs were used, state the character of same and depth placed, from \_\_\_\_\_ feet to \_\_\_\_\_ feet for each plug set.

3650' back to 313' heavy rotary mud with plug and 15 sacks of cement placed through drill pipe. 313' back to 40' heavy rotary mud with top plug and 10 sacks cement placed through drill pipe.

(If additional description is necessary, use BACK of this sheet)

Name of Plugging Contractor Buick Drilling Inc.  
Address Box 331  
St. John, Kansas

STATE OF Kansas, COUNTY OF Stafford, ss.  
Operator (employee of owner) or (owner or operator) of the above-described well,  
being first duly sworn on oath, says: That I have knowledge of the facts, statements, and matters herein contained and the log of the above-described well as filed and that the same are true and correct. So help me God.

(Signature) [Signature]

St. John, Kansas  
(Address)

SUBSCRIBED AND SWORN to before me this 29 day of December 1951

[Signature]  
Notary Public.

My commission expires \_\_\_\_\_

RECEIVED HARRY W. JOHNSON  
STATE CORPORATION COMMISSION NOTARY PUBLIC  
Commission expires June 9, 1955

PLUGGING  
FILE SEC-16T-21-12-51  
BOOK PAGE 130 LINE 24

JAN - 2 1952 1-2-52

BUICK DRILLING CO. INC., and Others  
Box #131  
St. John, Kansas

Olmstead #1

NE-NE-SE

Commenced R.D.: 11-25-51  
Completed R.D.: 12-7-51  
Total Depth: 3650' R.T.  
Casing Record: 313' of 8 5/8"

Sec. 16-21-12  
Stafford County, Kansas  
Elevation 1854 - D.F.  
Initial Prod: Arbuckle  
Contractor: Buick Drilling Inc.

Strata	Depth
Sand and Gravel	0 - 275
Red Bed	275 - 295
Red Bed and Shale	295 - 645
Anhydrite Lime	645 - 668
Shale and Shells	668 - 1200
Salt and Shale	1200 - 1520
Lime	1520 - 1600
Lime and Shale	1600 - 1700
Broken Lime	1700 - 1865
Lime and Shale	1865 - 2110
Broken Lime	2110 - 2305
Shale	2305 - 2530
Lime and Shale	2530 - 3265
Lime	3265 - 3350
Lime and Shale	3350 - 3388
Lime	3388 - 3440
Lime and Shale	3440 - 3521
Shale and Chert	3521 - 3622
Lime and Shale	3622 - 3635
Lime	3635 - 3650 T.D.

I hereby certify the above a true and correct drilling log as reflected by the drilling reports of the Buick Drilling Inc.

BUICK DRILLING INC.

*H. R. Buick*

H. R. Buick President

State of Kansas County Stafford, ss:  
Signed and sworn to in my presence this 29 day of December, 1951, by H. R. Buick,  
President of the Buick Drilling Inc.

*Harry W. Johnson*  
Notary Public

My Commission Expires: \_\_\_\_\_

HARRY W. JOHNSON  
NOTARY PUBLIC  
Commission expires June 9, 1955

PLUGGING  
FILE SEC 16 of 12  
BOOK PAGE 150 LINE 24

REC  
STATE CORP  
JAN - 2 1952  
CONSERVATION DIVISION  
Wichita, Kansas