

# WELL PLUGGING RECORD


STATE OF KANSAS  
STATE CORPORATION COMMISSION

Give All Information Completely  
Make Required Affidavit  
Mail or Deliver Report to:  
Conservation Division  
State Corporation Commission  
800 Biting Building  
Wichita, Kansas

## FORMATION PLUGGING RECORD

Strike out upper line  
when reporting plug-  
ging of formations.

County Stafford Sec. 16 Twp. 21 Rge. (E) 12 (W)  
 Location as "NE $\frac{1}{4}$ NW $\frac{1}{4}$ SW $\frac{1}{4}$ " or footage from lines NE $\frac{1}{4}$  NE $\frac{1}{4}$  NE $\frac{1}{4}$   
 Lease Owner G. W. Keyes Drilling Company, et al  
 Lease Name McCullough Well No. 1  
 Office Address Ellinwood, Kansas  
 Character of Well (completed as Oil, Gas or Dry Hole) Dry Hole  
 Date well completed March 7 1949  
 Application for plugging filed " 7 1949  
 Application for plugging approved " 7 1949  
 Plugging commenced " 7 1949  
 Plugging completed " 7 1949  
 Reason for abandonment of well or producing formation Dry Hole

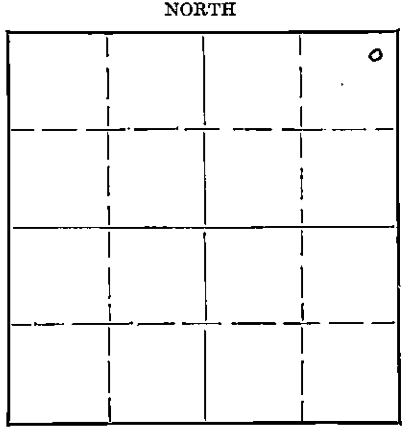

Locate well correctly on above Section Plat

If a producing well is abandoned, date of last production none 19      
 Was permission obtained from the Conservation Division or its agents before plugging was commenced? yes  
 Name of Conservation Agent who supervised plugging of this well C. D. Stough  
 Producing formation none Depth to top      Bottom      Total Depth of Well 3705 Feet  
 Show depth and thickness of all water, oil and gas formations.

OIL, GAS OR WATER RECORDS CASING RECORD

Formation	Content	From	To	Size	Put In	Pulled Out
Surface Pipe		0	263'	8 5/8"	263'	none

Describe in detail the manner in which the well was plugged, indicating where the mud fluid was placed and the method or methods used in introducing it into the hole. If cement or other plugs were used, state the character of same and depth placed, from      feet to      feet for each plug set.

Filled hole with heavy mud to 263'. Set rock bridge at 263'. Cemented with 20 sacks cement. Mudded hole to within 30' of top. Set rock bridge and cemented with ten sacks, cement returning to surface.

RECEIVED  
 CONSP. DIV.  
 MAR 14 1949  
 STATE CORPORATION COMMISSION  
 KANSAS

(If additional description is necessary, use BACK of this sheet)  
 Correspondence regarding this well should be addressed to G. W. Keyes Drilling Company  
 Address Ellinwood, Kansas

STATE OF KANSAS, COUNTY OF BARTON, ss.  
I, G. W. Keyes, Part Owner of the above-described well,  
 being first duly sworn on oath, says: That I have knowledge of the facts, statements, and matters herein contained and the log of the above-described well as filed and that the same are true and correct. So help me God.  
 (Signature) G. W. Keyes  
Ellinwood, Kansas  
 (Address)

SUBSCRIBED AND SWORN to before me this 9th day of March, 1949.  
George A. Meyer  
 Notary Public.

My commission expires February 10, 1951  
**PLUGGING**  
 FILE SEC 46-721-1120  
 BOOK PAGE 16 PAGE 5

WELL LOG

G. W. KEYES DRILLING COMPANY, et al, OWNERS - McCullough # 1  
NE 1/4 NE 1/4 NE 1/4 Section 16, Township 21, Range 12 W  
Stafford County, Kansas

Elevation: 1849 DF

Pipe Record:

8 5/8" set at 263'

Tops corrected 3' to derrick floor.

Kansas city 3262'  
Conglomerate 3484'

Rotary commenced 2-26-49  
completed 3- 7-49

Figures indicate bottom of formation  
0 to 235 sand and shale  
265 shale  
645 shale and shells  
675 anhydrite  
1140 shale and shells  
1230 salt, shale and shells  
1560 shale, sand and shells  
1760 shale and lime  
2025 lime, shale and sand  
2175 lime and shale  
2320 broken lime  
2450 lime and shale  
2625 shale and shells  
2775 shale  
3450 lime and shale  
3487 lime  
3705 conglomerate  
3705 Total Depth D & A

STATE OF KANSAS )  
COUNTY OF BARTON ) SS

I, G. W. Keyes, Part Owner, of the above-described well, being first duly sworn on oath, declare: That I have knowledge of the facts, statements and matters herein contained pertaining to the log of the above-described well, as filed, and that the same are true and correct.

*G. W. Keyes*

Subscribed and Sworn to before me this 14th day of March, 1949.

*George A. Meyer*  
Notary Public

RECEIVED  
Conservation Div.

My commission expires Feb. 10, 1951.

MAR 14 1949  
STATE CORPORATION  
COMMISSION  
KANSAS

PLUGGING  
FILE SEC 16 T 21 R 12 W  
BOOK PAGE 8 LINE 5