


WELL PLUGGING RECORD

Give All Information Completely
Make Required Affidavit
Mail or Deliver Report to:
Conservation Division
State Corporation Commission
800 Bittling Building
Wichita, Kansas

NORTH

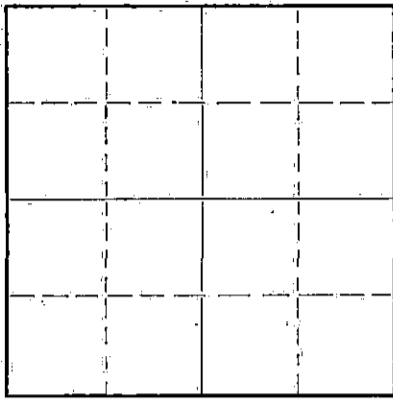

Locate well correctly on above
Section Flat

Stafford County, Sec. 11 Twp. 21 Rge. 12 (E) (W)
Location as "NE/CNW $\frac{1}{4}$ SW $\frac{1}{4}$ " or footage from lines NW SW
Lease Owner Penguin Petroleum, Inc.
Lease Name Wolf Well No. 1
Office Address 709 Petroleum Building
Character of Well (completed as Oil, Gas or Dry Hole) Dry hole
Date well completed June 29, 1950
Application for plugging filed June 29, 1950
Application for plugging approved June 29, 1950
Plugging commenced June 29, 1950
Plugging completed June 29, 1950
Reason for abandonment of well or producing formation Dry hole

If a producing well is abandoned, date of last production 19
Was permission obtained from the Conservation Division or its agents before plugging was commenced? Yes

Name of Conservation Agent who supervised plugging of this well C. D. Stough
Producing formation Depth to top Bottom Total Depth of Well 3590 Feet
Show depth and thickness of all water, oil and gas formations.

OIL, GAS OR WATER RECORDS

CASING RECORD

Formation	Content	From	To	Size	Put In	Pulled Out
		Surface	255'	8 5/8"	255'	none

Describe in detail the manner in which the well was plugged, indicating where the mud fluid was placed and the method or methods used in introducing it into the hole. If cement or other plugs were used, state the character of same and depth placed, from feet to feet for each plug set.

Fill hole with heavy mud
Put bottom plug @ 250' - cement with 15 sxs.
Top plug @ 30' - cement with 10 sxs.

JUL 7 1950
7-7-50
CONSERVATION DIVISION

(If additional description is necessary, use BACK of this sheet)
Correspondence regarding this well should be addressed to Penguin Petroleum, Inc.
Address 709 Petroleum Building Wichita, Kansas

STATE OF KANSAS, COUNTY OF SEDGWICK, ss.
JACK BROWN (employee of owner) or (owner or operator) of the above-described well,
being first duly sworn on oath, says: That I have knowledge of the facts, statements, and matters herein contained and the log of the above-described well as filed and that the same are true and correct. So help me God.

(Signature) Jack Brown
709 Petroleum Building (Address)

SUBSCRIBED AND SWORN to before me this 30th day of June, 1950
D. D. Strickland Notary Public.

My commission expires October 13, 1952
22-5188-s 9-48-10M

PLUGGING
FILE SEC 11 T 21 R 12
BOOK PAGE 14 LINE 9

Company: Phillips & Hansen
 Farm: Wolf #1

Section 11, T 21 S, R 12 W
 NW SW
 Stafford County, Kansas
 Rotary Tools
 Elevation: 1845' D.F.
 Total Depth: 3590'
 Dry & abandoned

Comm: June 19, 1950
 Comp: June 29, 1950
 Contractor: Penguin Petroleum, Inc.
 Casing: 8 5/8" @ 253' cem. w/200 ax.

0-220	Sand, gravel
-253	Red bed
-625	Red rock
-650	Anhydrite, lime
-845	Red rock
-1470	Shale and shells
-1710	Lime and shale
-1915	Lime broken
-2300	Lime and shale
-2490	Shale and shells
-2730	Lime and shale
-2762	Lime
-2795	Shale
-3058	Lime
-3090	Lime and shale
-3140	Lime brown
-3216	Shale
-3220	Lime
-3235	Shale
-3450	Lime
-3491	Varicolored shale
-3498	Shale
-3516	Cherty conglomerate
-3575	Shale
-3590	Chert
3590	Total Depth

Tops: Topska	@ 2795'
Heebner	@ 3031'
Brown Lansing	@ 3216'
White Lansing	@ 3229'
Base Kansas City	@ 3446'
Cherty Conglomerate	@ 3493'

Show of oil 3512-13'
 Show of oil 3415-20'

RECEIVED

Certified to be a true copy of the well log as indicated on daily drilling reports.

PENGUIN PETROLEUM, INC.
 JUL 7 - 1950
 STATE COMMISSION
 JACK BROWN

Subscribed and sworn to before me, the undersigned, a Notary Public, in and for Sedgwick County, Kansas, this 6th day of July, 1950.

My Commission Expires:
 October 13, 1952

[Signature]
 Notary Public

PLUGGING
 FILE 11-11-71-R-12
 BOOK PAGE 49 LINE 9