


WELL PLUGGING RECORD

Give All Information Completely
Make Required Affidavit
Mail or Deliver Report to:
Conservation Division
State Corporation Commission
211 No. Broadway
Wichita, Kansas

Stafford County. Sec. 10 Twp. 21S Rge. 12 (E) W (W)

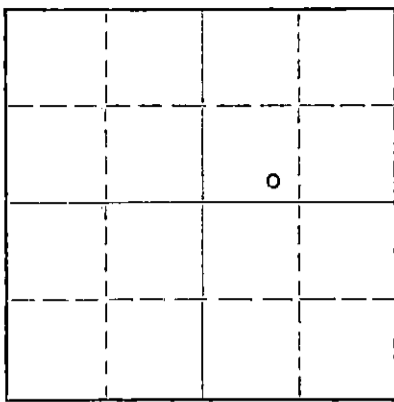

Locate well correctly on above Section Plat

Location as "NE/CNW/SW" or footage from lines _____
Lease Owner Duke Drilling Company
Lease Name Laudick "B" Well No. 1
Office Address P.O. Box 123 Great Bend, Kansas
Character of Well (completed as Oil, Gas or Dry Hole) Dry
Date well completed 29, September, 19 59
Application for plugging filed 29, September, 19 59
Application for plugging approved _____ 19 _____
Plugging commenced 29, September 19 59
Plugging completed 29, September 19 59
Reason for abandonment of well or producing formation _____

If a producing well is abandoned, date of last production _____ 19 _____
Was permission obtained from the Conservation Division or its agents before plugging was commenced? Yes

Name of Conservation Agent who supervised plugging of this well Mr. Boardfoot
Producing formation _____ Depth to top _____ Bottom _____ Total Depth of Well 3533 Feet
Show depth and thickness of all water, oil and gas formations.

OIL, GAS OR WATER RECORDS

CASING RECORD

FORMATION	CONTENT	FROM	TO	SIZE	PUT IN	PULLED OUT

Describe in detail the manner in which the well was plugged, indicating where the mud fluid was placed and the method or methods used in introducing it into the hole. If cement or other plugs were used, state the character of same and depth placed, from _____ feet to _____ feet for each plug set.

³⁵³³
Filled hole with heavy mud from 10 to 240'. Plug with hulls and 20 sacks wet cement pumped through drill pipe. Filled hole with heavy mud to 35', Plug with hulls and 10 sacks wet cement.

RECEIVED
STATE CORPORATION COMMISSION
OCT 1 1959
CONSERVATION DIVISION
Wichita, Kansas

(If additional description is necessary, use BACK of this sheet)

Name of Plugging Contractor _____
Address _____

STATE OF Kansas COUNTY OF Barton, ss.
Lewis O. Chubb (employee of owner) or (~~owner~~) of the above-described well, being first duly sworn on oath, says: That I have knowledge of the facts, statements, and matters herein contained and the log of the above-described well as filed and that the same are true and correct. So help me God.

(Signature) Lewis O. Chubb
Great Bend, Kansas
(Address)

SUBSCRIBED AND SWORN TO before me this 29th day of September, 19 59

My commission expires June 24, 1963 Clair E. Stimson Notary Public.



WELL LOG

Date Started September 18, 1959
Date Completed September 29, 1959

Laudick "B" # 1
80' N. of G. E/2 W/2 E/2
Section 10-21S-12W
Stafford County, Kansas

Elevation	1846	KB
Anhydrite	595'	1251'
Heebner	3065'	1219'
Toronto	3084'	1238'
Douglas	3099'	1253'
Iatan	3198'	1352'
Lansing	3212'	1366'
Simpson	3433'	1587'
Arbuckle	3487'	1641'
RFD	3533'	1687'
Surface Casing	8 5/8"	@ 241'

0'	- 208'	Surface Sand
208'	- 241'	Red Beds
241'	- 595'	Red Beds
595'	- 624'	Anhydrite
624'	- 795'	Shale & Shells
795'	- 1495'	Shells & Shale
1495'	- 1640'	Shale & Lime
1640'	- 1861'	Lime & Shale
1861'	- 2130'	Lime & Shale
2130'	- 2500'	Shale & Lime
2500'	- 2835'	Lime & Shale
2835'	- 3065'	Lime
3065'	- 3069'	Shale - Heebner
3069'	- 3075'	Lime
3075'	- 3084'	Shale
3084'	- 3098'	Lime - Toronto
3098'	- 3198'	Shale - Douglas
3198'	- 3212'	Lime, Shale - Iatan
3212'	- 3433'	Lime, Shale, - Lansing
3433'	- 3487'	Shale - Simpson
3487'	- 3533'	Dolomite Arbuckle
3533'		Rotary T.D.

RECEIVED
STATE CORPORATION COMMISSION
OCT 1 1959
CONSERVATION DIVISION
WICHITA, KANSAS

AFFIDAVIT

State of Kansas County of Barton

I, Lewis O. Chubb, employee of the owner, do swear that the statements and matters herein contained are true to the best of my knowledge.

THE DUKE DRILLING COMPANY

By: Lewis O. Chubb

Subscribed and sworn to before me this 30th day of September, 1959.

Clare E. Stevenson
Notary Public

My Commission Expires: June 24, 1963