


Give All Information Completely
Make Required Affidavit
Mail or Deliver Report to:
Conservation Division
State Corporation Commission
211 No. Broadway
Wichita, Kansas

WELL PLUGGING RECORD

NORTH

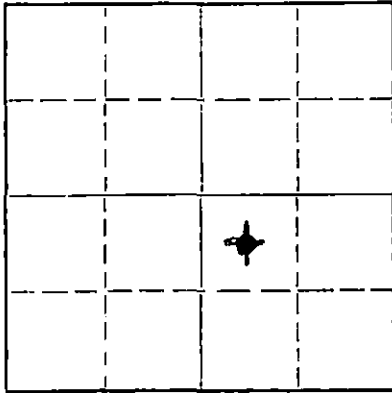

Locate well correctly on above
Section Flat

Stafford County, Sec. 10 Twp. 21 Rge. 12 (E) W (W)
Location as "NE/CNWxSWx" or footage from lines NW SE. SE.
Lease Owner Bea Dribling Co., Inc.
Lease Name Laudick "C" Well No. 2
Office Address Box 247, Ellinwood, Kansas
Character of Well (completed as Oil, Gas or Dry Hole) Dry hole
Date well completed 11/2/64 19
Application for plugging filed Verbally, 11/2/64 19
Application for plugging approved 11/4/64 19
Plugging commenced 6 P.M. 11/2/64 19
Plugging completed 8 P.M. 11/2/64 19
Reason for abandonment of well or producing formation _____

If a producing well is abandoned, date of last production _____ 19
Was permission obtained from the Conservation Division or its agents before plugging was commenced? Yes

Name of Conservation Agent who supervised plugging of this well A. Elving
Producing formation _____ Depth to top _____ Bottom _____ Total Depth of Well 3575 Feet
Show depth and thickness of all water, oil and gas formations.

OIL, GAS OR WATER RECORDS

CASING RECORD

FORMATION	CONTENT	FROM	TO	SIZE	PUT IN	PULLED OUT
		0	290	8 5/8	290	None

Describe in detail the manner in which the well was plugged, indicating where the mud fluid was placed and the method or methods used in introducing it into the hole. If cement or other plugs were used, state the character of same and depth placed, from _____ feet to _____ feet for each plug set.

Filled hole w/ heavy mud to 275 ft.
Set bottom plug @275 ft, plus 1/2 sack hulls,
Run 25 sacks cement,
Mudded to 40 ft, set plug @40 ft,
Run 10 sacks cement.
Run 2 sacks cement in rat hole, filled w/soil.

RECEIVED
STATE CORPORATION COMMISSION

NOV 9 1964

CONSERVATION DIVISION
Wichita, Kansas

11-9-64

(If additional description is necessary, use BACK of this sheet)

Name of Plugging Contractor Bea Drilling Co., Inc.
Address Box 247, Ellinwood, Kansas

STATE OF Kansas, COUNTY OF Barton, ss.
C. F. Krehbiel (employee of owner) or (owner or operator) of the above-described

well, being first duly sworn on oath, says: That I have knowledge of the facts, statements, and matters herein contained and the log of the above-described well as filed and that the same are true and correct. So help me God.

(Signature) C. F. Krehbiel
C. F. Krehbiel, Box 247, Ellinwood, Ks.
(Address)

SUBSCRIBED AND SWORN TO before me this 6th day of November, 19 64

WALTER L. ROTH, NOTARY PUBLIC
My Commission Expires Jan. 20, 1967

Walter L. Roth
Notary Public.



Bea Drilling Co., Inc.
 et al
 #2 Laudick "C"
 Nw SE SE Section 10-21S-12 W
 Stafford County, Kans.

Staked: 10/19/64
 Started: 10/26/64
 Completed: 11/3/64

Elevation: 1838 Gr. 1843 KB
 Tops:

Casing Record:

Run 14 jts, 290 ft 8 5/8" 20#
 8 v thd casing, cemented w/180
 sacks, circulated. Plug down @
 10 P.M. 10/26/64

Anhydrite	630	/1213
Heebner	3090	-1247
Brown Lime	3226	-1383
Lansing-K.C.	3241	-1398
Viola	3471	-1628
Simpson	3492	-1655
Arbuckle	3534	-1691

DRILL STEM TESTS: None

Drillers Log

(All measurements to bottom of formations)

Surface sand, clay	45
Shale, sand	245
Shale	285
Red bed	565
Shale & shells	630
Anhydrite	655
Shale & shells	1365
Shale & lime	1630
Lime & shale	2046
Shale	2260
Shale & lime	2810
Lime & shale	3025
Lime	3079
Lime & shale	3090
Heebner	3094
Lime & shale	3122
Shale	3200
Lime-shale	3450
Lime, sand, shale	3575
Roatry Total Depth	3575

RECORDED
 STATE GEOLOGICAL SURVEY
 NOV 9 1964
 CONSERVATION DIVISION
 Wichita, Kansas

I hereby certify that the above log of said well is true
 and correct as reflected by the daily drilling reports.

C. F. Krehbiel
 C. F. Krehbiel, Vice-Pres.
 Bea Drilling Co., Inc. (Contr.)

STATE OF KANSAS, COUNTY OF BARTON, ss

Subscribed and sworn to before me this 6th day of November,
 1964.

 Notary Public

My commission expires _____