


STATE OF KANSAS
STATE CORPORATION COMMISSION

Give All Information Completely
Make Required Affidavit
Mail or Deliver Report to:
Conservation Division
State Corporation Commission
212 No. Market
Wichita, Kansas

WELL PLUGGING RECORD

NORTH

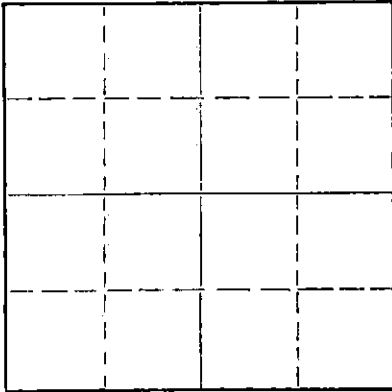

Locate well correctly on above
Section Plat

Stafford County, Sec. 10 Twp. 21 Rge. 12 (E) W (W)
Location as "NE/CNW/SE/SW" or footage from lines NW NW SW
Lease Owner Circle Oil Company
Lease Name Hallman Well No. 1
Office Address 500 Bitting Bldg. Wichita
Character of Well (completed as Oil, Gas or Dry Hole) _____
Date well completed _____ 19____
Application for plugging filed June 13 19 68
Application for plugging approved June 17 19 68
Plugging commenced July 1 19 68
Plugging completed July 3 19 68
Reason for abandonment of well or producing formation _____

If a producing well is abandoned, date of last production _____ 19____
Was permission obtained from the Conservation Division or its agents before plugging was commenced? yes

Name of Conservation Agent who supervised plugging of this well Ralph Warren
Producing formation _____ Depth to top _____ Bottom _____ Total Depth of Well _____ Feet
Show depth and thickness of all water, oil and gas formations.

OIL, GAS OR WATER RECORDS

CASING RECORD

FORMATION	CONTENT	FROM	TO	SIZE	PUT IN	PULLED OUT
				8 5/8	283	none
				5 1/2	3497	2529

Describe in detail the manner in which the well was plugged, indicating where the mud fluid was placed and the method or methods used in introducing it into the hole. If cement or other plugs were used, state the character of same and depth placed, from _____ feet to _____ feet for each plug set.

Plugged back with sand from 3515' to 3470'. Mixed and dumped 5 sx cement from 3470' to 3430'. Pulled casing. Mudded hole to 270'. Set 20' rock bridge from 270' to 250'. Dumped 3 yds. of ready mixed concrete from 250' to base of the cellar.

RECEIVED
STATE CORPORATION COMMISSION
JUL 16 1968
CONSERVATION DIVISION
Wichita, Kansas

(If additional description is necessary, use BACK of this sheet)

Name of Plugging Contractor Russ Casing Pulling, Inc.
Address Box 1082 Great Bend, Kansas 67530


STATE OF KANSAS, COUNTY OF SEDGWICK, ss.
Wayne W. Kahmeyer

(employee of owner) or (owner or operator) of the above-described well, being first duly sworn on oath, says: That I have knowledge of the facts, statements, and matters herein contained and the log of the above-described well as filed and that the same are true and correct. So help me God.

(Signature) Wayne W. Kahmeyer
500 Bitting Building, Wichita, Kansas
(Address)

Subscribed and sworn to before me this 15th day of July 19 68

Louise K. Whitted
Louise K. Whitted - Notary Public.

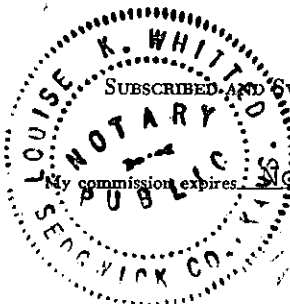

DRILLERS LOGHALLMAN NO. 1

CASING RECORD:	COMPANY:	Circle Oil Company	DESCRIPTION:
8-5/8" @ 283' w/225 sax cement	CONTRACTOR:	Sage Drilling Co.	NW NW SW Sec. 10-21S-12W Stafford County, Kansas
TOTAL DEPTH: 3505'	COMMENCED:	January 5, 1967	ELEVATION: 1853KB
	COMPLETED:	January 11, 1967	

<u>FORMATION</u>	<u>FROM</u>	<u>TO</u>	<u>REMARKS</u>
Surface Soil	0	284	
Red Bed	284	636	
Anhydrite	636	661	
Shale	661	1703	
Lime & Shale	1703	2030	
Shale & Lime	2030	2803	
Lime & Shale	2803	3088	
Shale	3088	3211	
Lime & Shale	3211	3505	

RECEIVED
STATE CORPORATION COMMISSION
JUN 17 1968
CONSERVATION DIVISION
Wichita, Kansas

I certify that this is a true and correct copy of the above log to the best of my knowledge.

SAGE DRILLING CO., INC.

By Lawrence F. Gray
Lawrence F. Gray

Subscribed and sworn to before me this 16th day of January, 1967.

Louise K. Whitted
Louise K. Whitted, Notary Public

My commission expires:
November 26, 1970.