


STATE OF KANSAS
STATE CORPORATION COMMISSION

Form CP-4

Give All Information Completely
Make Required Affidavit
Mail or Deliver Report to:
Conservation Division
State Corporation Commission
212 No. Market
Wichita, Kansas

WELL PLUGGING RECORD

NORTH

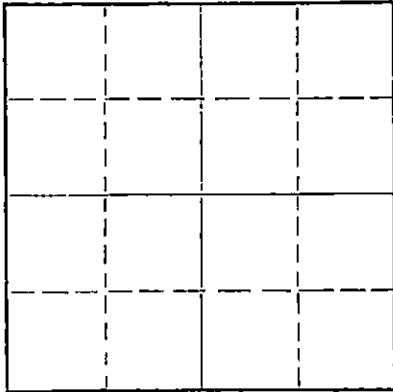

Locate well correctly on above
Section Plat

Stafford County. Sec. 10 Twp. 21S Rge. (E) 12W (W)
Location as "NE/CNW/SW" or footage from lines. SE NE NW
Lease Owner Circle Oil Company, Inc.
Lease Name CHRISTIANSEN Well No. 1
Office Address 500 Bitting Building, Wichita, Kansas
Character of Well (completed as Oil, Gas or Dry Hole) Dry Hole
Date well completed October 28, 1966
Application for plugging filed 19
Application for plugging approved 19
Plugging commenced October 28, 1966
Plugging completed October 28, 1966
Reason for abandonment of well or producing formation Dry Hole

If a producing well is abandoned, date of last production 19
Was permission obtained from the Conservation Division or its agents before plugging was commenced? Yes (Archie Elving)

Name of Conservation Agent who supervised plugging of this well
Producing formation Depth to top Bottom Total Depth of Well 3555 Feet
Show depth and thickness of all water, oil and gas formations.

OIL, GAS OR WATER RECORDS

CASING RECORD

FORMATION	CONTENT	FROM	TO	SIZE	PUT IN	PULLED OUT
	Surface	0	275'	10-3/4"	10/21/66	-----
	Casing					

Describe in detail the manner in which the well was plugged, indicating where the mud fluid was placed and the method or methods used in introducing it into the hole. If cement or other plugs were used, state the character of same and depth placed, from feet to feet for each plug set.

Heavy Mud from Total Depth to 260 Feet;
Hulls, Plug and 30 sacks cement thru the
Drill Pipe; Mud to 40 feet; 1/2 sack Hulls
and Plug bridged w/kelley and cement to
base of cellar; 2 sacks in rat hole.
Job completed @ 1:45 P.M.

11-2-66

RECEIVED
STATE CORPORATION COMMISSION
NOV 9 1966
CONSERVATION DIVISION
WICHITA, KANSAS

(If additional description is necessary, use BACK of this sheet)

Name of Plugging Contractor Sage Drilling Co.
Address 500 Bitting Building, Wichita, Kansas

STATE OF KANSAS, COUNTY OF SEDGWICK, ss.
Lawrence F. Gray (employee of owner) or (owner or operator) of the above-described well, being first duly sworn on oath, says: That I have knowledge of the facts, statements, and matters herein contained and the log of the above-described well as filed and that the same are true and correct. So help me God.

(Signature) Lawrence F. Gray
500 Bitting Building, Wichita, Kansas (Address)

SUBSCRIBED AND SWORN TO before me this 1st day of November, 1966
Louise K. Whitted - Notary Public

My commission expires November 26, 1966.

DRILLERS LOGCHRISTIANSEN NO. 1

CASING RECORD:	COMPANY:	Circle Oil Co., Inc.	DESCRIPTION:
10-3/4" @ 275'	CONTRACTOR:	Sage Drilling Co.	SE NE NW
w/250 sax cement	COMMENCED:	October 21, 1966	Sec. 10-21S-12W
TOTAL DEPTH:	COMPLETED:	October 28, 1966	Stafford County, Kans.
3555'			ELEVATION: 1855KB

<u>FORMATION</u>	<u>FROM</u>	<u>TO</u>	<u>REMARKS</u>
Surface Soil	0	275	
Red Bed	275	628	
Anhydrite	628	652	
Shale & Shells	652	1657	
Lime & Shale	1657	2443	
Shale & Lime	2443	2800	
Lime	2800	2980	
Lime & Shale	2980	3090	
Shale & Lime	3090	3214	
Lime	3214	3490	
Lime & Shale	3490	3555	

I certify that this is a true and correct copy of the above log to the best of my knowledge.

SAGE DRILLING COMPANY, INC.

By Lawrence F. Gray
Lawrence F. Gray

Subscribed and sworn to before me this 1st day of November, 1966.

Louise K. Whitted
Louise K. Whitted, Notary Public

My commission expires:
November 26, 1966,