


STATE OF KANSAS
STATE CORPORATION COMMISSION

WELL PLUGGING RECORD

Give All Information Completely
Take Required Affidavit
Mail or Deliver Report to
Conservation Division
State Corporation Comm.
245 North Water
Wichita, KS 67202

Stafford County, Sec. 26 Twp. 21SRge. 14 E/W
Location as "NE/CNW/SW" or footage from lines
SW/4 NE/4 NW/4

Lease Owner American Energies Corp.
Lease Name McGinty Well No. #1-26
Office Address 575 Fourth Financial Ctr., Wichita, KS
Character of Well (Completed as Oil, Gas or Dry Hole) dry hole

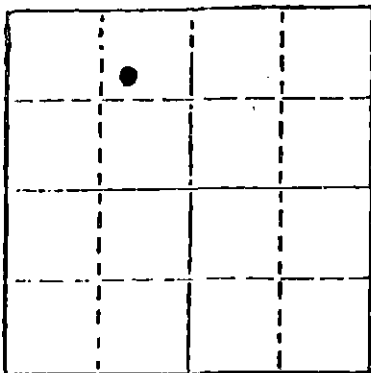

Date Well completed 8/09/81
Application for plugging filed 8/09/81
Application for plugging approved 8/09/81
Plugging commenced 8/09/81
Plugging completed 8/09/81
Reason for abandonment of well or producing formation
No commercial quantity of gas or oil encountered.
If a producing well is abandoned, date of last production
19

Was permission obtained from the Conservation Division or
its agents before plugging was commenced? yes

Name of Conservation Agent who supervised plugging of this well Mr. Lesli
Producing formation _____ Depth to top _____ Bottom _____ Total Depth of Well _____
Show depth and thickness of all water, oil and gas formations.

OIL, GAS OR WATER RECORDS

CASING RECORD

FORMATION	CONTENT	FROM	TO	SIZE	PUT IN	PULLED OUT

Describe in detail the manner in which the well was plugged, indicating where the mud fluid was placed and the method or methods used in introducing it into the hold. If cement or other plugs were used, state the character of same and depth placed, from _____ feet to _____ feet for each plug set.

Total Depth 3805 feet. Set first plug at 620 feet with 60 sacks cement, second plug at 260 feet with 40 sacks cement, 10 sacks and bridge at 40 feet and 10 sacks in rat hole. Cement by Sun Cementing. Job complete at 7:05 a.m. on August 9, 1981. State Plugger - Mr. Lesli.

RECEIVED
STATE CORPORATION COMMISSION

AUG 19 1981 8-19-81

(If additional description is necessary, use BACK of this sheet)

Name of Plugging Contractor Kaw Drilling Co., Inc.

CONSERVATION DIVISION
Wichita, Kansas


STATE OF KANSAS COUNTY OF SEDGWICK, ss. contractor
K. S. Martin, President of Kaw Drilling Co., Inc. of the above-described well, being first duly sworn on oath, says: That I have knowledge of the facts, statements, and matters herein contained and the log of the above-described well as filed and that the same are true and correct. So help me God.

(Signature) [Signature]
K. S. Martin, President, 1010 Union Center
(Address) Wichita, KS 67202

SUBSCRIBED AND SWORN TO before me this 18th day of August, 1981.

My commission expires December 10, 1983

[Signature]
Mary Susan Whaley Notary Public.

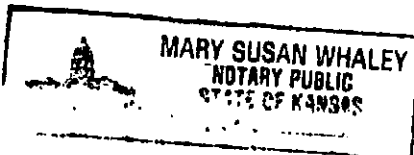

OPERATOR:	AMERICAN ENERGIES CORPORATION
CONTRACTOR:	Kaw Drilling Co., Inc.
WELL NAME:	McGINTY #1-26
LOCATION:	SW NE NW Section 26-21S-14W, Stafford County, Kansas
SPUD DATE:	August 2, 1981
COMPLETION DATE:	August 9, 1981

0 - 3562	Shale
3563 - 3610	Shale and Lime
3678 - 3805	Shale
3805	R.T.D.

Spud hole at 1:15 p.m. on August 2, 1981. Drilled 255 feet of 12 1/4 inch hole. Ran 8 joints of 8 5/8 inch, 23 pound new surface casing. (Tallied at 243.95 feet.) Set at 255 feet with 200 sacks of common cement, 2% Gel, 3% CC. Plug was down at 6:30 p.m. on August 2, 1981.

Total Depth 3805 feet. Set first plug at 620 feet with 60 sacks of cement, second plug at 260 feet with 40 sacks, 10 sacks and a bridge at 40 feet and 10 sacks in rat hole. Cement by Sun Cementing. Job complete at 7:15 a.m. on August 9, 1981. State Plugger - Mr. Lesli.

STATE OF KANSAS)
) ss
COUNTY OF SEDGWICK)

I, K. S. Martin, President of Kaw Drilling Co., Inc., being first duly sworn and upon my oath, state that: I have knowledge of the facts, statements and matters herein contained and the log of the above described well as filed and that the same are true and correct. So help me God.

K. S. Martin


K. S. Martin, President

SUBSCRIBED AND SWORN to before me on this 18th day of August, 1981.

Mary Susan Whaley

Mary Susan Whaley, Notary Public

My Commission Expires:
December 10, 1983

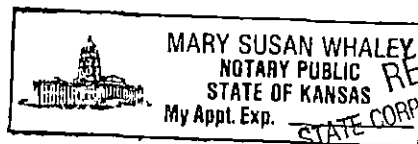

RECEIVED
AUG 19 1981
CONSERVATION DIVISION
Wichita, Kansas