


STATE OF KANSAS
STATE CORPORATION COMMISSION
Give All Information Completely
Make Required Affidavit
Mail or Deliver Report to:
Conservation Division
State Corporation Commission
211 No. Broadway
Wichita, Kansas

WELL PLUGGING RECORD

STAFFORD County. Sec. 26 Twp. 21s Rge. 14W (E) (W)
Location as "NE/CNWxSWx" or footage from lines NE NE NW
Lease Owner PETROLEUM, INC.
Lease Name MCGINTY "C" Well No. 1
Office Address ROUTE 2, GREAT BEND, KANSAS
Character of Well (completed as Oil, Gas or Dry Hole) DRY HOLE
Date well completed OCTOBER 5 1961
Application for plugging filed = OCTOBER 5 1961
Application for plugging approved OCTOBER 5 1961
Plugging commenced OCTOBER 5 1961
Plugging completed OCTOBER 5 1961
Reason for abandonment of well or producing formation NO PRODUCIBLE ZONES

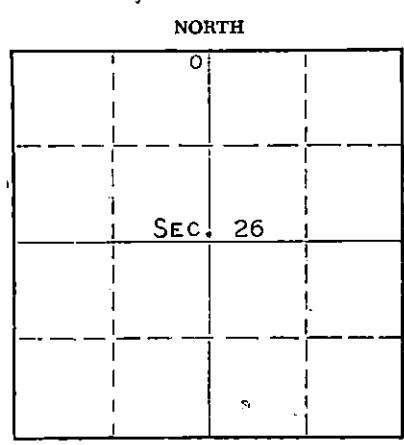

Locate well correctly on above Section Plat

If a producing well is abandoned, date of last production NONE 19__
Was permission obtained from the Conservation Division or its agents before plugging was commenced? YES

Name of Conservation Agent who supervised plugging of this well FRED W. HAMPEL
Producing formation _____ Depth to top _____ Bottom _____ Total Depth of Well 3761 Feet
Show depth and thickness of all water, oil and gas formations.

OIL, GAS OR WATER RECORDS

CASING RECORD

FORMATION	CONTENT	FROM	TO	SIZE	PUT IN	PULLED OUT
				8-5/8"	256'	NONE

Describe in detail the manner in which the well was plugged, indicating where the mud fluid was placed and the method or methods used in introducing it into the hole. If cement or other plugs were used, state the character of same and depth placed, from _____ feet to _____ feet for each plug set.

MUDDED UP WITH HEAVY MUD TO 240' FOLLOWED BY WOODEN PLUG AND 1/4 SACK HULLS.
PLACED 20 SACKS CEMENT THROUGH DRILL PIPE ONTO HULLS. MUDDED UP WITH HEAVY MUD TO 35' FOLLOWED BY WOODEN PLUG, 1/4 SACK HULLS AND 10 SACKS CEMENT TO BASE OF WELL CELLAR.

RECEIVED
STATE CORPORATION COMMISSION
OCT 23 1961
CONSERVATION DIVISION
Wichita, Kansas

(If additional description is necessary, use BACK of this sheet)
Name of Plugging Contractor GARVEY DRILLING COMPANY
Address ROUTE 2, GREAT BEND, KANSAS

STATE OF KANSAS, COUNTY OF BARTON, ss.
DON SEARLE (employee of owner) or (owner) of the above-described well, being first duly sworn on oath, says: That I have knowledge of the facts, statements, and matters herein contained and the log of the above-described well as filed and that the same are true and correct. So help me God.
(Signature) Don Searle
ROUTE 2, GREAT BEND, KANSAS (Address)

SUBSCRIBED AND SWORN TO before me this 18TH day of OCTOBER, 1961

My commission expires APRIL 14, 1963
Arthur J. Mule Notary Public.



WELL LOG

15.185.01038.0000

COMPANY **PETROLEUM, INCORPORATED**

SEC. 26 T. 21S R. 14W

FARM **MC GINTY "C" NO. 1**


LOC. NE, NE, NW

TOTAL DEPTH **3761'**

COUNTY **STAFFORD CO. KANSAS**

COMM. **September 26, 1961** COMP. **October 5, 1961**

CONTRACTOR **GARVEY DRILLING COMPANY**

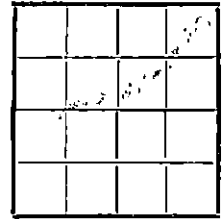

CASING **8-5/8" @ 256' w/225 sax.**

ELEVATION **1933' DF**

PRODUCTION **D & A**

FIGURES INDICATE BOTTOM OF FORMATIONS

175	Clay, sand & gravel
300	Shale & red bed
832	Red bed & shale
860	Anhydrite
1540	Shale & shells
1900	Shale w/lime streaks
2200	Lime
3115	Lime & shale
3761	Lime
3761	T. D.

RECEIVED
STATE CORPORATION COMMISSION

OCT 23 1961

CONSERVATION DIVISION
Wichita, Kansas

State of KANSAS
County of BARTON } SS

I, VERNE A. MORRIS of GARVEY DRILLING COMPANY

upon oath state the above and foregoing is a true and correct copy of the log of the #17 McGINTY "C" well.

Verne A. Morris

Subscribed and sworn to before me this 17th day of October 19 61

My Commission Expires: April 14, 1963

Arthur J. Miles
NOTARY PUBLIC