


WELL PLUGGING RECORD

Give All Information Completely
Make Required Affidavit
Mail or Deliver Report to:
Conservation Division
State Corporation Commission
800 Biting Building
Wichita, Kansas

NORTH

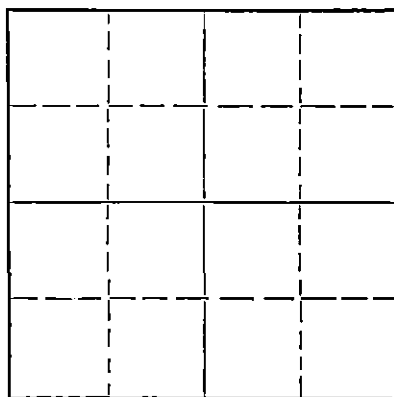

Locate well correctly on above
Section Plot

Stafford County, Sec. 26 Twp. 21 Rge. (E) 14 (W)
Location as "NE/CNW $\frac{1}{4}$ SW $\frac{1}{4}$ " or footage from lines C E/2 NW SE
Lease Owner Murfin Drilling Co., et al
Lease Name Pelter Well No. 2
Office Address Un. Natl. Bank Bldg., Wichita, Ks.
Character of Well (completed as Oil, Gas or Dry Hole) Dry Hole
Date well completed 8-13-51 19
Application for plugging filed 8-13-51 19
Application for plugging approved 8-13-51 19
Plugging commenced 8-13-51 19
Plugging completed 8-13-51 19
Reason for abandonment of well or producing formation

If a producing well is abandoned, date of last production 19
Was permission obtained from the Conservation Division or its agents before plugging was commenced? Yes

Name of Conservation Agent who supervised plugging of this well C. D. Stough
Producing formation Depth to top Bottom Total Depth of Well 3795 Feet
Show depth and thickness of all water, oil and gas formations.

OIL, GAS OR WATER RECORDS

CASING RECORD

Formation	Content	From	To	Size	Put In	Pulled Out
				8 5/8	366	-0-

Describe in detail the manner in which the well was plugged, indicating where the mud fluid was placed and the method or methods used in introducing it into the hole. If cement or other plugs were used, state the character of same and depth placed, from feet to feet for each plug set.

Cemented hole w/bottom plug @ 300' through drill pipe
w/15 sacks cement. Top plug @ 40' w/10 sacks cement.

STATE CORPORATION COMMISSION
WICHITA, KANSAS

(If additional description is necessary, use BACK of this sheet) SEP 18 1951
Name of Plugging Contractor Murfin Drilling Co.
Address Un. Natl. Bank Bldg., Wichita, Ks. CONSERVATION DIVISION
Wichita, Kansas

STATE OF Kansas, COUNTY OF Sedgwick, ss.
W. R. Murfin (employee of owner) or (owner or operator) of the above-described well,
being first duly sworn on oath, says: That I have knowledge of the facts, statements, and matters herein contained and the log of the above-described well as filed and that the same are true and correct. So help me God.

(Signature) *W.R. Murfin*
Wichita, Ks.
(Address)

SUBSCRIBED AND SWORN to before me this 17th day of September, 19 51.

Helen Horine
Notary Public.

My commission expires 6-4-55 23-8390-s 6-51-20M

PLUGGING
FILE SEC 26 T 21 R 14 W
BOOK PAGE 105 LINE 11

KANSAS WELL LOG BUREAU --- KANSAS GEOLOGICAL SOCIETY
508 EAST MURDOCK - WICHITA, KANSAS

COMPANY Murfin Drilling Co., et al
FARM Pelter NO. 2

SEC. 26 T. 21 R. 14W
LOC. C E/2 NW SE

TOTAL DEPTH 3795
COMM. 7-31-51 COMP. 8-13-51
SHOT OR TREATED
CONTRACTOR Murfin Drilling Co.
ISSUED

COUNTY Stafford
KANSAS

CASING
20 10
15 8 366
12 6
13 5

ELEVATION 1929 Gr.
PRODUCTION Dry

FIGURES INDICATE BOTTOM OF FORMATIONS

190 sand & clay
265 shale & shells
280 sand
351 sand & shale
460 red bed
845 red bed, shale, shells
875 Anhydrite
1150 shale & red rock
1345 shale & shells
1570 salt & shale
1675 shale & shells
1860 lime-shale
1960 sandy lime
2000 lime-shells
2100 shale & lime
2205 lime & shale
2325 shale & shells
2490 shale & lime
2620 shale
2755 shale & shells
2830 shale & lime
2905 lime
3010 lime & shale
3665 lime
3700 shale-lime
3740 lime
3780 sandy lime
3795 lime

Tops
Heebner 3292
Brown Lime 3413
Lansing 3424
Viola 3700
Simpson 3750
Reworked Arb. 3782
Arb. 3792

3424
1929

1495

STATE OF KANSAS)
) SS:
SEDGWICK COUNTY)

I, W. R. Murfin, of the Murfin Drilling Co., upon oath state that the above and foregoing is a true and correct copy of the log of the #2 Pelter well.

W. R. Murfin
W. R. Murfin

Subscribed and sworn to before me this 17th day of September, 1951.

Helen Horvath
Notary Public

My Commission Expires: 6-4-55

PLUGGING
WELL SEC. 26 T. 21 R. 14W
BOOK PAGE 123 JUNE 11

SEP 8 1951